



**CHABOT-LAS POSITAS
COMMUNITY COLLEGE DISTRICT
PURCHASING DEPARTMENT**

April 20, 2022

**Addendum No. 03
INVITATION TO BID.: B21/22-10
Boiler Removal & Replacement Chabot College**

To: All Prospective Bidders

This **Addendum Three (3)** is issued to incorporate the following changes, additions or deletions to the **IFB (B21/22-10)**. Any modifications/changes made by this addendum affect only the portions or paragraphs specifically identified herein; all remaining portions of the **IFB (B21/22-10)** to remain in force. It is the responsibility of all responders to conform to this addendum.

A. ADDITIONS, CHANGES AND/OR CLARIFICATIONS:

CLARIFICATIONS: Please see attached As Built documents for the Central Utility Plant at Chabot College.

All other terms and conditions remain unchanged.

Michael McClung - Buyer, Purchasing and Warehouse Services
Chabot-Las Positas Community College District


SITE UNDERGROUND UTILITY PIPING PROJECT CHABOT COMMUNITY COLLEGE CHABOT - LAS POSITAS COMMUNITY COLLEGE DISTRICT

25555 HESPERIAN BOULEVARD
HAYWARD, CA 94545




25555 HESPERIAN BLVD.
HAYWARD, CALIFORNIA

SITE PLAN

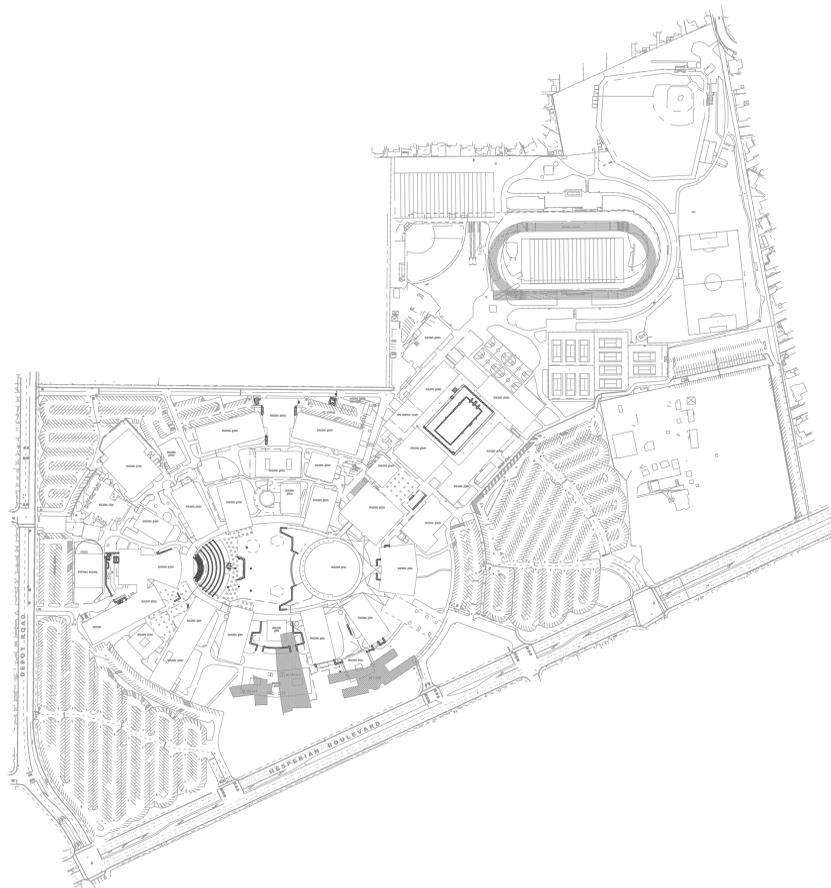

LOCAL MAP

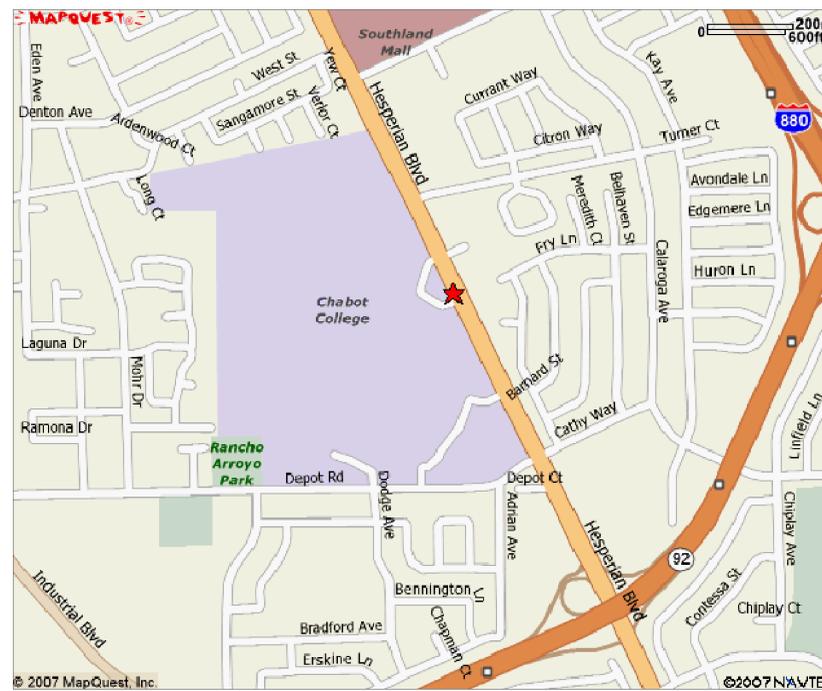

DRAWING SHEET INDEX

DWG #	DRAWING DESCRIPTION	DRAWING SET ISSUE #			
		50%CD	90%CD	IFC	as-built
M0.00	PROJECT COVER SHEET AND DRAWING SHEET INDEX	N	N	N	R
M0.01	LEGENDS, ABBREVIATIONS AND PROJECT NOTES	N	N	R	R
M0.02	MECHANICAL SPECIFICATIONS	N	N	R	R
M0.03	MECHANICAL DETAILS	N	R	R	R
M0.03	MECHANICAL SCHEDULES				R
M0.04	MECHANICAL SCHEDULES				R
CIU.0	CIVIL - OVERALL SITE PLAN	-	N	R	R
CIU.1	CIVIL - PARTIAL SITE PLAN	-	N	R	R
CIU.2	CIVIL - PARTIAL SITE PLAN	-	N	R	R
CIU.3	CIVIL - PARTIAL SITE PLAN	-	N	R	R
CIU.4	CIVIL - PARTIAL SITE PLAN	-	N	R	R
CIU.5	CIVIL - PARTIAL SITE PLAN	-	N	R	R
CIU.0	CIVIL CONSTRUCTION DETAILS	N	R	R	R
MP1U.0	HYDRONIC PIPING - OVERALL SITE PLAN	N	R	R	R
MP1U.1	HYDRONIC PIPING -PARTIAL SITE PLAN	N	R	R	R
MP1U.2	HYDRONIC PIPING -PARTIAL SITE PLAN	N	R	R	R
MP1U.3	HYDRONIC PIPING -PARTIAL SITE PLAN	N	R	R	R
MP1U.4	HYDRONIC PIPING -PARTIAL SITE PLAN	N	R	R	R
MP1U.5	HYDRONIC PIPING -PARTIAL SITE PLAN	N	R	R	R
MP4.1	BUILDING 2800 ENLARGED PARTIAL MECHANICAL PIPING FLOOR PLAN	N	R	R	R
MP4.3	ENLARGED PARTIAL MECHANICAL YARD PLAN				R
MP5.1	HOT WATER PIPING DIAGRAM				R
MP5.2	CONDENSER WATER PIPING DIAGRAM				R
MP5.3	CHILLED WATER PIPING DIAGRAM-PRIMARY				R
MP5.4	CHILLED WATER PIPING DIAGRAM-SECONDARY				R
PIU.0	UNDERGROUND PLUMBING PIPING - OVERALL SITE PLAN	N	R	R	R
PIU.1	UNDERGROUND PLUMBING PIPING - PARTIAL SITE PLAN	N	R	R	R
PIU.2	UNDERGROUND PLUMBING PIPING - PARTIAL SITE PLAN	N	R	R	R
PIU.3	UNDERGROUND PLUMBING PIPING - PARTIAL SITE PLAN	N	R	R	R
PIU.4	UNDERGROUND PLUMBING PIPING - PARTIAL SITE PLAN	N	R	R	R
PIU.5	UNDERGROUND PLUMBING PIPING - PARTIAL SITE PLAN	N	R	R	R
PIU.6	UNDERGROUND PLUMBING PIPING - PARTIAL SITE PLAN	N	R	R	R
PL4.1	BUILDING 2800 ENLARGED PARTIAL UNDERGROUND UNDERGROUND PLAN	N	R	R	R
PL4.2	ENLARGED PARTIAL PLUMBING UNDERGROUND YARD PLAN				R
PL4.3	BUILDING 2800 ENLARGED PARTIAL PLUMBING FLOOR PLAN				R
PL4.4	BUILDING 2800 ENLARGED PARTIAL PLUMBING ROOF PLAN				R
E0.0	SYMBOLS AND ABBREVIATIONS	N	-	R	R
E0.0	OVERALL SITE PLAN - ELECTRICAL	N	-	R	R
E0.1	PART SITE PLAN - ELECTRICAL UNDERGROUND	N	-	R	R
E0.2	PART SITE PLAN - ELECTRICAL UNDERGROUND	N	-	R	R
E0.3	PART SITE PLAN - ELECTRICAL UNDERGROUND	N	-	R	R
E0.4	PART SITE PLAN - ELECTRICAL UNDERGROUND	N	-	R	R
E0.5	PART SITE PLAN - ELECTRICAL UNDERGROUND	N	-	R	R
E0.6	ELECTRICAL DETAILS	N	-	R	R

THE INCORPORATED STATE OF CALIFORNIA REGISTERED PROFESSIONAL ENGINEERS STAMP SERVES AS THE SELF CERTIFICATION FOR THESE DOCUMENTS.

SOUTHLAND INDUSTRIES

 775 Commercial Street
 San Jose, CA 95112
 Tel: 408.970.3777
 Fax: 408.970.3776

ALL DRAWINGS PREPARED BY SOUTHLAND INDUSTRIES ARE THE EXCLUSIVE PROPERTY OF SOUTHLAND INDUSTRIES AND, UNLESS OTHERWISE AGREED IN WRITING, SOUTHLAND INDUSTRIES SHALL BE DEEMED THE AUTHOR OF THEM AND SHALL RETAIN ALL COMMON LAW, STATUTORY AND OTHER RESERVED RIGHTS. IN ADDITION TO THE COPYRIGHT, ANY USE THEREOF WITHOUT THE EXPRESS WRITTEN CONSENT OF SOUTHLAND INDUSTRIES IS PROHIBITED



NO.	DESCRIPTION	DATE
-	50% CONSTRUCTION DOCUMENTS	08/31/07
-	90% CONSTRUCTION DOCUMENTS	09/21/07
-	ISSUED FOR CONSTRUCTION	11/05/07
-	AS-BUILT	03/06/09

KEY PLAN

PROJECT TITLE
CHABOT COMMUNITY COLLEGE
CENTRAL PLANT PROJECT

SHEET TITLE
**PROJECT COVER
SHEET AND DRAWING
SHEET INDEX**

PROJECT NO. 5617065	UNIT	CHECKED BY
SCALE: NONE		
DATE 04-16-2007	SHEET NO.	MO.00

PROJECT TEAM

GENERAL CONTRACTORS

SOUTHLAND INDUSTRIES

 775 Commercial Street
 San Jose, CA 95112
 Tel: 408.970.3777
 Fax: 408.970.3776

CIVIL ENGINEERS

SANDIS CIVIL ENGINEERS

 SURVEYORS
 PLANNERS
 1721 Broadway, Suite 201
 Oakland, CA 94612
 Tel: 510.873.8864
 Fax: 510.873.8868

MECHANICAL / PLUMBING

SOUTHLAND INDUSTRIES

 775 Commercial Street
 San Jose, CA 95112
 Tel: 408.970.3777
 Fax: 408.970.3776

ELECTRICAL

REDWOOD CITY ELECTRIC, INC.

 114 Hazel Ave.
 Redwood City, CA 94061
 Tel: 650.369.5776
 Fax: 650.369.4963

HVAC LEGEND				
SYMBOL	ABBREV	DESCRIPTION	SYMBOL	ABBREV DESCRIPTION
	CWS	CONDENSER WATER SUPPLY		LINED DUCT (INSIDE CLEAR SIZE SHOWN)
	CWR	CONDENSER WATER RETURN		DUCT UP
	CHWS	CHILLED WATER SUPPLY		DUCT DOWN
	CHWR	CHILLED WATER RETURN		DUCT SECTION (SUPPLY)
	MCHWS	MEDIUM TEMP CHILLED WATER SUPPLY		DUCT SECTION (RETURN OR OSA)
	MCHWR	MEDIUM TEMP CHILLED WATER RETURN		DUCT SECTION (EXHAUST)
	HWS	HEATING HOT WATER SUPPLY		POINT OF STATIC PRESSURE CHANGE
	HWR	HEATING HOT WATER RETURN		CEILING DIFFUSER
	RL	REFRIGERANT LIQUID		RETURN REGISTER (CEILING MOUNTED)
	RS	REFRIGERANT SUCTION		RETURN GRILLE (CEILING MOUNTED)
	HG	REFRIGERANT HOT GAS		EXHAUST REGISTER (CEILING MOUNTED)
	LPS	LOW-PRESSURE STEAM		EXHAUST GRILLE (CEILING MOUNTED)
	HPS	HIGH-PRESSURE STEAM		SIDEWALL SUPPLY REGISTER
	PCR	PUMPED CONDENSATE RETURN		SIDEWALL SUPPLY GRILLE
	GCR	GRAVITY CONDENSATE RETURN		SIDEWALL RETURN REGISTER
	BFW	BOILER FEED WATER		SIDEWALL RETURN GRILLE
	BLDN	BOILER BLOWDOWN		SIDEWALL EXHAUST REGISTER
	CD	CONDENSATE DRAIN		SIDEWALL EXHAUST GRILLE
	D	DRAIN		TRANSFER GRILLE
	SCW	SOFT COLD WATER		MANUAL VOLUME DAMPER
	ICW	INDUSTRIAL COLD WATER		MOTORIZED VOLUME DAMPER
	IHW	INDUSTRIAL HOT WATER		FIRE DAMPER
	PCW	PROCESS COOLING WATER		FIRE/SMOKE DAMPER
	RO	REVERSE OSMOSIS WATER		SMOKE DETECTOR
	DI	DEIONIZED WATER		FLEXIBLE CONNECTION
	GS	GLYCOL SUPPLY		ACCESS DOOR
	GR	GLYCOL RETURN		ACCESS PANEL
	CFS	CHEMICAL FEED SYSTEM		THERMOSTAT
	AV	ATMOSPHERIC VENT		HUMIDISTAT
	RV	RELIEF VENT		SWITCH
	FOS	FUEL OIL SUPPLY		DOOR LOUVER
	FOR	FUEL OIL RETURN		DOOR UNDERCUT
	NG	NATURAL GAS		MOTOR LOCATION
		BUTTERFLY VALVE		HEPA OR ULPA FILTER (NON-DUCTED)
		BALL VALVE		HEPA OR ULPA FILTER (DUCTED)
		GATE VALVE		HEPA OR ULPA FILTER W/LIGHT (DUCTED)
		GLOBE VALVE		
		PLUG VALVE		
		CHECK VALVE		
		CONTROL VALVE, ELECTRIC		
		CONTROL VALVE, PNEUMATIC		
		BUTTERFLY VALVE, MOTOR OPERATED		
		SOLENOID VALVE		
	PSV	PRESSURE RELIEF VALVE		
	PRV	PRESSURE REGULATING VALVE		
	PRV	PRV (SELF CONTAINED)		
		STRAINER		
		UNION		
		CONCENTRIC REDUCER (OR INCREASER)		
		ECCENTRIC REDUCER (OR INCREASER)		
		PIPE ELBOW TURNED UP		
		PIPE ELBOW TURNED DOWN		
		PIPE TEE, BRANCH OUTLET UP		
		PIPE TEE, BRANCH OUTLET DOWN		
		CAP		
		BLIND FLANGE		
		FLANGED JOINT		
		GROOVED JOINT		
		ANCHOR		
		ALIGNMENT GUIDE		
	FLEX CONN	FLEXIBLE CONNECTION (METALLIC)		
	FLEX CONN	FLEXIBLE CONNECTION (NEOPRENE)		
	PG	PRESSURE GAUGE		
	THERM	THERMOMETER		
	AV	AUTOMATIC AIR VENT		
	MV	MANUAL AIR VENT		
		PRESS/TEMP PORT (PETIE'S PLUG)		
	FS	FLOW SWITCH (DIFFERENTIAL PRESSURE)		

ABBREVIATIONS			
ABBREV	DESCRIPTION	ABBREV	DESCRIPTION
ABV	ABOVE FINISHED FLOOR	OC	ON CENTER
AD	ACCESS DOOR	OD	OPEN DRIP PROOF
AP	ACCESS PANEL	OSD	OPPOSED BLADE DAMPER
ACH	AIR CHANGES PER HOUR	OSA	OUTSIDE AIR
AC OR A/C	AIR CONDITIONING	OD	OUTSIDE DIAMETER OR DIMENSION
AFC	AIR FLOW MEASUREMENT STATION	OPD	OVERCURRENT PROTECTIVE DEVICE
AHU	AIR HANDLING UNIT	O ₂	OXYGEN GAS
AS	AIR SEPARATOR	PPM	PARTS PER MILLION
AMB	AMBIENT	PH	PHASE
AMPS	AMPERES	PL	PLUMBING CONTRACTOR
Ar	ARGON	PC	PUMPED CONDENSATE
ATM	ATMOSPHERE, ATMOSPHERIC	POC	POINT OF CONNECTION
AV	AUTOMATIC AIR VENT	PP	POLYPROPYLENE PIPE
AUX	AUXILIARY	PVC	POLYVINYL CHLORIDE
BDD	BACKDRAFT DAMPER	PVDF	POLYVINYLIDENE FLUORIDE
BG	BLAST GATE	POS	POSITION
BF	BOTTOM FLAT, BLIND FLANGE	PSI	POUNDS PER SQUARE INCH
BOD	BOTTOM OF DUCT	PRESS	PRESSURE
BOP	BOTTOM OF PIPE	ΔP	PRESSURE CHANGE
BHP	BRAKE HORSEPOWER	PCV	PRESSURE CONTROL VALVE
BTU	BRITISH THERMAL UNIT	PG	PRESSURE GAGE
BTUH	BRITISH THERMAL UNIT PER HOUR	PRV	PRESSURE REGULATING VALVE
BLDG	BUILDING	PRV	PRIMARY CHILLED WATER
CA	CAPACITY	RAU	RECIRCULATION AIR UNIT
CD	CEILING DIFFUSER	RDE	RECOMMENDED DUAL ELEMENT FUSE
CHW	CHILLED WATER	RL	REFRIGERANT LIQUID
CIRC	CIRCUIT	RS	REFRIGERANT SUCTION
CB	CIRCUIT BREAKER	RHC	REHEAT COIL
CDA	CLEAN DRY AIR	RH	RELATIVE HUMIDITY
COP	COEFFICIENT OF PERFORMANCE	(R)	RELOCATED
COND	CONDENSATE (STEAM)	REQ'D	REQUIRED
CD	CONDENSATE DRAIN (A/C)	RA	RETURN AIR
CV	CONDENSER WATER	RG	RETURN GRILLE
CY	CONSTANT VOLUME	RR	RETURN REGISTER
CP	CONTROL PANEL	RO	REVERSE OSMOSIS
CFM OR CF	CUBIC FEET PER MINUTE	RP	REVOLUTIONS PER MINUTE
°C	DEGREE CELSIUS	RM	ROOM
°F	DEGREE FAHRENHEIT	RLA	RUNNING LOAD AMPS
DI	DEIONIZED	SI	INTERNATIONAL SYSTEM OF UNITS
DP	DIFFERENTIAL PRESSURE	SCHED	SCHEDULE
DDC	DIRECT DIGITAL CONTROL	SCE	SCRUBBED EXHAUST
DISCH	DISCHARGE	SC	SCRUBBER
DS	DISCONNECT SWITCH	SCHW	SECONDARY CHILLED WATER
DOW	DOMESTIC (POTABLE) COLD WATER	SHT	SHEET
D/L	DOOR LOUVER	SD	SMOKE DETECTOR, SMOKE DAMPER
DN	DOWN	SE	SOLENT EXHAUST
DR	DRAIN	SA	SOUND ATTENUATOR
DWG	DRAWING	SS	STAINLESS STEEL
DB	DRY BULB TEMPERATURE	SP	STATIC PRESSURE
EFF	EFFICIENCY	STM	STEAM
EGC	EGGCRATE GRILLE	SCADA	SUPERVISORY CONTROL AND DATA ACQUISITION
EDH	ELECTRIC DUCT HEATER	SA	SUPPLY AIR
ELEV	ELEVATION	SG	SUPPLY GRILLE
EER	ENERGY EFFICIENCY RATIO	SR	SUPPLY REGISTER
EAT	ENTERING AIR TEMPERATURE	TU	TERMINAL UNIT
EWT	ENTERING WATER TEMPERATURE	THERM	THERMOMETER
EQUIP	EQUIPMENT	TSTAT	THERMOSTAT
ECW	EQUIPMENT COOLING WATER	TF	TOP FLAT
EVAP	EVAPORATIVE	TDH	TOTAL DYNAMIC HEAD
EA	EXHAUST AIR	TP	TOTAL PRESSURE
EG	EXHAUST GRILLE	TSP	TOTAL STATIC PRESSURE
ER	EXHAUST REGISTER	TC	TRANSFER GRILLE
(E) or E	EXISTING	TYP	TYPICAL
ESP	EXTERNAL STATIC PRESSURE	U/C	UNDERCUT
FCU	FAN COIL UNIT	UNO	UNLESS NOTED OTHERWISE
FT	FEET	UTR	UP THRU ROOF
FPM	FEET PER MINUTE	VD	MANUAL VOLUME DAMPER
FRP	FIBERGLASS REINFORCED PLASTIC	VAV	VARIABLE AIR VOLUME
FD	FIRE DAMPER	VTR	VENT THROUGH ROOF
F/LS	FIRE/LIFE SAFETY	VERT	VERTICAL
F/SD	FIRE/SMOKE DAMPER	V	VOLTS
FLR	FLOOR	VAC	VOLTS ALTERNATING CURRENT
FD	FLOOR DRAIN	VDC	VOLTS DIRECT CURRENT
FS	FLOOR SINK	WC	WATER CLOSET
FLA	FULL LOAD AMPS	W	WATTS
FE	FUME EXHAUST	WPDS	WEATHERPROOF DISCONNECT SWITCH
(F) or F	FUTURE	WT	WEIGHT
GPH	GALLONS PER HOUR	WB	WET BULB TEMPERATURE
GPM	GALLONS PER MINUTE	WSA	WIRE SIZING AMPS
GC	GENERAL CONTRACTOR	W/	WITH
HX	HEAT EXCHANGER	W/O	WITHOUT
HE	HEAT EXHAUST	X'MER	TRANSFORMER
HTG	HEATING		
HW	HEATING HOT WATER		
HVAC	HEATING, VENTILATING, AND AIR CONDITIONING		
HZ	HERTZ		
HPC	HIGH-PRESSURE CONDENSATE		
HPS	HIGH-PRESSURE STEAM		
HORIZ	HORIZONTAL		
HP	HORSEPOWER		
HV	HOUSEKEEPING VACUUM		
H ₂ STAT	HUMIDISTAT		
H ₂	HYDROGEN GAS		
HG	REFRIGERANT HOT GAS		
IN	INCHES		
ICW	INDUSTRIAL COLD WATER		
IHW	INDUSTRIAL HOT WATER		
ID	INSIDE DIAMETER OR DIMENSION		
KV	KILOVOLTS		
KVA	KILOVOLT AMPERES		
KW	KILOWATTS		
LAT	LEAVING AIR TEMPERATURE		
LWT	LEAVING WATER TEMPERATURE		
(L)	LINED		
LN ₂	LIQUID NITROGEN		
LRA	LOCKED ROTOR AMPS		
LPC	LOW-PRESSURE CONDENSATE		
LPS	LOW-PRESSURE STEAM		
LBS	POUNDS		
MUA	MAKE UP AIR		
MAU	MAKE UP AIR UNIT		
MB	MAN-BARS		
MV	MANUAL AIR VENT		
MAX	MAXIMUM		
MCB	MAXIMUM CIRCUIT BREAKER		
MFS	MAXIMUM FUSE SIZE		
MOP	MAXIMUM OVERCURRENT PROTECTION		
MECH	MECHANICAL		
MC	MECHANICAL CONTRACTOR		
MER	MECHANICAL EQUIPMENT ROOM		
MS	MEMORY STOP (ON A VALVE)		
MEZZ	MEZZANINE		
MIN	MINIMUM OR MINUTE		
MCA	MINIMUM CIRCUIT AMPACITY		
MA	MIXED AIR		
MOD	MODULATING		
MCC	MOTOR CONTROL CENTER		
MTD	MOUNTED		
MBH	THOUSAND BTUH		
NPSH	NET POSITIVE SUCTION HEAD		
(N) or N	NEW		
N ₂	NITROGEN GAS		
NPW	NON-POTABLE WATER		
N.C.	NORMALLY CLOSED		
N.O.	NORMALLY OPEN		
NIC	NOT IN CONTRACT		
NTS	NOT TO SCALE		
NO.	NUMBER		

ENERGY NOTES

- DUCT INSULATION
 - ALL DISTRIBUTION SYSTEM DUCTS AND PLENUMS, INCLUDING, BUT NOT LIMITED TO, BUILDING CAVITIES, MECHANICAL CLOSETS, AIR HANDLER BOXES AND SUPPORT PLATFORMS USED AS DUCTS OR PLENUMS, SHALL BE INSTALLED, SEALED AND INSULATED TO MEET REQUIREMENT OF 2001 CMC SECTION 601, 603, 604, 605 AND STANDARD 6-5 INCORPORATED HEREIN BY REFERENCE AND ALSO MEET THE REQUIREMENTS OF THE SPECIFICATIONS.
 - CONNECTIONS OF METAL DUCT AND THE INNER CORE OF FLEXIBLE DUCTS SHALL BE MECHANICALLY FASTENED.
 - OPENINGS SHALL BE SEALED WITH MASTIC, TAPE, AEROSOL SEALANT, OR OTHER DUCT-CLOSURE SYSTEM THAT MEETS THE APPLICABLE REQUIREMENT OF UL 181, UL 181A, OR UL 181B.
 - PORTIONS OF SUPPLY-AIR AND RETURN-AIR DUCTS CONVEYING HEATING OR COOLED AIR LOCATED IN ONE OR MORE OF FOLLOWING SPACES SHALL BE INSULATED TO A MINIMUM INSTALLED LEVEL OF R-8:
 - OUTDOORS, OR
 - IN SPACE BETWEEN THE ROOF AND AN INSULATED CEILING, OR
 - IN SPACE DIRECTLY UNDER ROOF WITH FIXED VENT OR OPENINGS TO THE OUTSIDE OR UNCONDITIONED SPACES, OR
 - IN AN UNCONDITIONED CRAWLSPACE; OR
 - IN THE OTHER UNCONDITIONED SPACES.

PORTIONS OF SUPPLY-AIR DUCTS THAT ARE NOT IN ONE OF THESE SPACES SHALL BE INSULATED TO A MINIMUM INSTALLED LEVEL OF R-4.2 (OR ANY HIGHER LEVEL REQUIRED BY CMC SECTION 605) OR BE ENCLOSED IN DIRECTLY CONDITIONED SPACE.
- PIPE INSULATION
 - PIPE INSULATION MUST BE INSTALLED IN COMPLIANCE WITH THE CALIFORNIA NON-RESIDENTIAL ENERGY CODE AND ALSO MEET THE REQUIREMENTS OF THE SPECIFICATIONS.
 - PIPING INSULATION, EXCEPT WHEN NEEDED TO PREVENT CONDENSATION, IS NOT REQUIRED IN ANY OF THE FOLLOWING:
 - FACTORY-INSTALLED PIPING WITHIN HVAC EQUIPMENT.
 - PIPING THAT CONVEYS FLUIDS WITH A DESIGN OPERATING TEMPERATURE RANGE BETWEEN 60 AND 105 DEGREES F.
 - PIPING THAT PENETRATES FRAMING MEMBERS SHALL NOT BE REQUIRED TO HAVE ISOLATION FOR THE DISTANCE OF FRAMING PENETRATION. METAL PIPING THAT PENETRATES METAL FRAMING SHALL USE GROMMETS, PLUGS, WRAPPING OR OTHER INSULATING MATERIAL TO ASSURE THAT NO CONTACT MADE WITH THE METAL FRAMING.
- MINIMUM PIPE INSULATION REQUIREMENTS FOR HEATING SYSTEMS AND COOLING SYSTEMS:

MINIMUM PIPE INSULATION (INCHES) ¹ HEATING SYSTEMS (HOT WATER)							
FLUID DESIGN OPERATING TEMPERATURE RANGE (°F)	INSULATION CONDUCTIVITY		NOMINAL PIPE DIAMETER (IN)				
	CONDUCTIVITY RANGE (BTU/IN)/(HR-SQ FT-F)	MEAN RATING TEMPERATURE (°F)	RUNOUTS ² UP TO 2	1 AND LESS	1 1/4 TO 2	2 1/2 TO 4	5 AND 8 AND UP
ABOVE 350	0.32-0.34	250	1.5	2.5	2.5	3.0	3.5
251-350	0.29-0.31	200	1.5	2.0	2.5	2.5	3.5
201-250	0.27-0.30	150	1.0	1.5	1.5	2.0	3.5
141-200	0.25-0.29	125	0.5	1.5	1.5	1.5	1.5
105-140	0.24-0.28	100	0.5	1.0	1.0	1.0	1.5

MINIMUM PIPE INSULATION (INCHES) ¹ COOLING SYSTEMS (CHILLED WATER, BRINE AND REFRIGERANT)							
FLUID DESIGN OPERATING TEMPERATURE RANGE (°F)	INSULATION CONDUCTIVITY		NOMINAL PIPE DIAMETER (IN)				
	CONDUCTIVITY RANGE (BTU/IN)/(HR-SQ FT-F)	MEAN RATING TEMPERATURE (°F)	RUNOUTS ² UP TO 2	1 AND LESS	1 1/4 TO 2	2 1/2 TO 4	5 AND 8 AND UP
40-60	0.23-0.27	75	0.5	0.5	0.50	1.0	1.0
BELOW 40	0.23-0.27	75	1.0	1.0	1.5	1.5	1.5

NOTES

 - INSULATION THICKNESS LEVELS ARE MINIMUMS AND DO NOT ADDRESS SPECIFIC NEEDS OF INSULATION FOR FREEZE PROTECTION OR FOR LIMITING VAPOR TRANSMISSION OR CONDENSATION.
 - RUNOUTS TO INDIVIDUAL TERMINAL UNITS NOT EXCEEDING 12 FEET IN LENGTH

GENERAL PROJECT NOTES

25555 HESPERIAN BLVD.
HAYWARD, CALIFORNIA

THE INCORPORATED STATE OF CALIFORNIA REGISTERED PROFESSIONAL ENGINEERS STAMP SERVES AS THE SELF CERTIFICATION FOR THESE DOCUMENTS.

SOUTHLAND INDUSTRIES

775 Commercial Street
San Jose, CA 95112
Tel: 408.970.3777
Fax: 408.970.3776

ALL DRAWINGS PREPARED BY SOUTHLAND INDUSTRIES ARE THE EXCLUSIVE PROPERTY OF SOUTHLAND INDUSTRIES AND, UNLESS OTHERWISE AGREED IN WRITING, SOUTHLAND INDUSTRIES SHALL BE DEEMED THE AUTHOR OF THEM AND SHALL RETAIN ALL COMMON LAW, STATUTORY AND OTHER RESERVED RIGHTS, IN ADDITION TO THE COPYRIGHT. ANY USE THEREOF WITHOUT THE EXPRESS WRITTEN CONSENT OF SOUTHLAND INDUSTRIES IS PROHIBITED

REVISIONS		
NO.	DESCRIPTION	DATE

UNDERGROUND CHILLED AND HEATING HOT WATER PIPING
XTRU-THERM (PERMA-PIPE) – GENERAL NOTES

1.0 GENERAL

- 1.1 THE SCALE SHOWN ON THE DRAWINGS IS FOR REFERENCE PURPOSES ONLY. DO NOT SCALE THE DRAWINGS, USE THE DIMENSIONS SHOWN.
- 1.2 THE LAYOUT DRAWING IS FOR REFERENCE PURPOSES ONLY. THE MATERIALS SUPPLIED BY PERMA-PIPE WILL BE IN ACCORDANCE WITH SECTION 5.0 – SCOPE OF SUPPLY.

2.0 PRODUCT DESCRIPTION

- 2.1 XTRU-THERM ECONOMY IS A FACTORY POLYURETHANE INSULATED AND HDPE JACKETED PIPING SYSTEM.
- 2.2 XTRU-THERM ECONOMY CONSISTS OF PREFABRICATED STRAIGHT LENGTHS AND FIELD ASSEMBLED AND INSULATED FITTINGS.

3.0 DESIGN CONDITIONS/CRITERIA

3.1 SERVICE PRESSURE AND TEMPERATURE:

SERVICE	PRESSURE (PSIG)	TEMPERATURE(DEG. F)
HOT WATER S&R	100 PSIG	190° F.
CHILLED WATER S&R	100 PSIG	60° F.

- 3.2 THE SERVICE PIPING IS DESIGNED AND MANUFACTURED IN ACCORDANCE WITH ASME B31.1.
- 3.3 A STRESS ANALYSIS OF THIS PIPING SYSTEM HAS BEEN MADE ASSUMING THE DIMENSIONS AND DESIGN CONDITIONS SHOWN ON THESE DRAWINGS ARE CORRECT. THE SYSTEM IS WITHIN THE LIMITS SET FORTH FOR ALLOWABLE STRESSES IN THE CODE, BASED UPON THE ASSUMPTIONS HEREIN.
- 3.4 THE SYSTEM IS DESIGNED TO ACCOMMODATE THE SERVICE PIPE THERMAL EXPANSION USING FIELD INSTALLED EXTERNAL EXPANSION PADS.
- 3.5 THE PIPING SYSTEM IS DESIGNED FOR THE ABOVE DESIGN CONDITIONS. IT IS THE PURCHASER'S RESPONSIBILITY TO VERIFY THIS INFORMATION IS CORRECT AND OPERATE THE SYSTEM WITHIN THE CONDITIONS DESIGNED FOR.

4.0 MATERIALS

ITEM	SIZE	MATERIAL
SERVICE PIPE	1"-1 1/2" SCHED 40	ASTM A106, SEAMLESS, GRADE B, CARBON STEEL PIPE
CHWS/R HWS/R	2"-10" SCHED 40 12" STD WT	ASTM A53, ERW, GRADE B, CARBON STEEL PIPE ASTM A53, ERW, GRADE B, CARBON STEEL PIPE
PIPE INSULATION	ALL	POLYURETHANE FOAM NOMINAL 2.0 LB./CU. FT. DENSITY ≥ 90% CLOSED CELL
INSULATION JACKET	ALL	HIGH DENSITY POLYETHYLENE (HDPE) ASTM D3350, GRADE PE3408
FITTING COVERS	ALL	PVC WITH SEALING TAPE
ANCHOR PLATES	ALL	A36 CARBON STEEL

5.0 SCOPE OF SUPPLY

PIPE SIZE	SERVICE PIPE NOMINAL SIZE (IN.) SCH.	HDPE JACKET		INSULATION THICKNESS (IN.)
		OD (IN.)	THICKNESS (IN.)	
8" HWSR	8" SCHED 40, A53, ERW, CS	11.8"	80 MILS	1.5"
6" HWSR	6" SCHED 40, A53, ERW, CS	9.8"	80 MILS	1.5"
5" HWSR	5" SCHED 40, A53, ERW, CS	8.8"	80 MILS	1.5"
4" HWSR	4" SCHED 40, A53, ERW, CS	7.8"	80 MILS	1.5"
3" HWSR	3" SCHED 40, A53, ERW, CS	6.7"	80 MILS	1.5"
2.5"HWSR	2.5" SCHED 40, A53, ERW, CS	6.0"	80 MILS	1.5"
2" HWSR	2" SCHED 40, A53, ERW, CS	5.6"	80 MILS	1.5"
12"CHWSR	12" STD WT, A53, ERW, CS	15.0"	120 MILS	1"
8"CHWSR	8" SCHED 40, A53, ERW, CS	10.8"	80 MILS	1"
6"CHWSR	6" SCHED 40, A53, ERW, CS	8.8"	80 MILS	1"
4"CHWSR	4" SCHED 40, A53, ERW, CS	6.7"	80 MILS	1"
3"CHWSR	3" SCHED 40, A53, ERW, CS	5.7"	80 MILS	1"
2.5"CHWSR	2.5" SCHED 40, A53, ERW, CS	5"	80 MILS	1"
2"CHWSR	2" SCHED 40, A53, ERW, CS	4.6"	80 MILS	1"

6.0 INSTALLATION

- 6.1 ALL PIPING SHALL BE INSTALLED AND TESTED IN ACCORDANCE WITH PERMA-PIPE'S INSTALLATION INSTRUCTION MANUAL FOR THIS PRODUCT.
- 6.2 PERMA-PIPE STRONGLY RECOMMENDS ALL FIELD JOINTS REMAIN UNCOVERED AND EXPOSED FOR FIELD TESTING PURPOSES.
- PERMA-PIPE DOES NOT RECOMMEND BACKFILLING PRIOR TO FIELD JOINT TESTING. VIOLATION OF THIS RECOMMENDATION MAY RESULT IN RE-EXCAVATION, REPAIRS AND RE-BACKFILLING AND WILL BE DONE AT THE INSTALLER'S COST AND RISK.
- 6.3 ANCHOR BLOCKS ARE REQUIRED AT ALL SERVICE PIPE ANCHOR LOCATIONS. ANCHOR BLOCKS SHALL BE FIELD POURED AND KEYED INTO UNDISTURBED SOIL BY THE INSTALLER. ALL ANCHOR BLOCKS SHALL BE COMPLETELY CURED BEFORE OPERATING OR TESTING THE SYSTEM.
- 6.4 SERVICE PIPE COUPLINGS, IF REQUIRED, ARE NOT SUPPLIED BY PERMA-PIPE.
- 7.0 FACTORY TESTING AND INSPECTION
- 7.1 THE SERVICE PIPE SHALL BE HYDROSTATICALLY TESTED BY THE PIPE MANUFACTURER ACCORDANCE WITH ITS RESPECTIVE ASTM DESIGNATION.
- 7.2 VISUALLY INSPECT ALL SPRAY APPLIED POLYURETHANE INSULATION PRIOR TO APPLYING THE HDPE JACKET.
- 8.0 FIELD JOINTS
- 8.1 THE SERVICE PIPE SHALL BE PNEUMATICALLY TESTED TO 125 PSIG PER ASME B31.9 1996 EDITION 937.4. INSULATION SHALL THEN BE POURED IN PLACE INTO THE FIELD JOINT AREA. THE INSTALLER SHALL SEAL THE FIELD JOINT AREA WITH A HEAT SHRINKABLE ADHESIVE BACKED SLEEVE. BACKFILLING SHALL NOT BEGIN UNTIL THE HEAT SHRINK SLEEVE HAS COOLED. ALL INSULATION AND JACKETING MATERIALS FOR THE FIELD JOINT SHALL BE BY PERMA-PIPE.

UNDERGROUND CITY WATER PIPE MATERIAL SCHEDULE

SYMBOL	SYSTEM	SIZE	PIPE MATERIAL
DCW	DOMESTIC COLD WATER	<4"	TYPE L COPPER, BRAZED POLYSLEEVE AT CONCRETE ANCHOR
DCW	UNDERGROUND DOMESTIC COLD WATER	>4"	PVC, C-900, CLASS 150, MJ FITTINGS, WITH STARGRIP RESTRAINTS (NO THRUST BLOCKS)



25555 HESPERIAN BLVD,
HAYWARD, CALIFORNIA

THE INCORPORATED STATE OF CALIFORNIA REGISTERED PROFESSIONAL ENGINEERS STAMP SERVES AS THE SELF CERTIFICATION FOR THESE DOCUMENTS.

SOUTHLAND INDUSTRIES



ALL DRAWINGS PREPARED BY SOUTHLAND INDUSTRIES ARE THE EXCLUSIVE PROPERTY OF SOUTHLAND INDUSTRIES AND, UNLESS OTHERWISE AGREED IN WRITING, SOUTHLAND INDUSTRIES SHALL BE DEEMED THE AUTHOR OF THEM AND SHALL RETAIN ALL COMMON LAW, STATUTORY AND OTHER RESERVED RIGHTS. IN ADDITION TO THE COPYRIGHT, ANY USE THEREOF WITHOUT THE EXPRESS WRITTEN CONSENT OF SOUTHLAND INDUSTRIES IS PROHIBITED





NO.	DESCRIPTION	DATE
-	50% CONSTRUCTION DOCUMENTS	08/31/07
-	90% CONSTRUCTION DOCUMENTS	09/21/07
-	ISSUED FOR CONSTRUCTION	11/05/07
-	AS-BUILT	03/06/09

KEY PLAN

PROJECT TITLE
CHABOT COMMUNITY COLLEGE
CENTRAL PLANT PROJECT

SHEET TITLE
**MECHANICAL
SPECIFICATIONS**


DRAWN BY	CHECKED BY
PROJECT NO. 5617065	UNIT
SCALE:	SHEET NO. MO.02
DATE 04-16-2007	

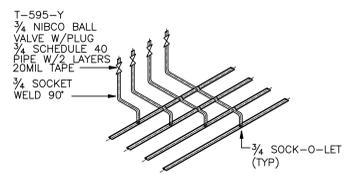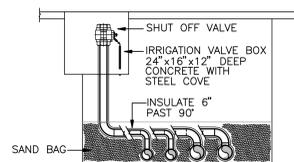

HIGH POINT VENT

SCALE NONE

10

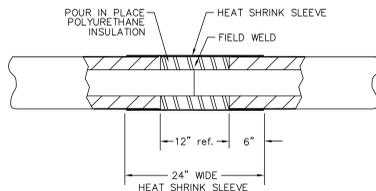


NOTES:
 1. SOCKET WELD COUPLINGS, IF REQUIRED SUPPLIED BY INSTALLER
 2. THE FOLLOWING FIELD JOINT MATERIAL SUPPLIED BY PERMA-PIPE
 POUR IN PLACE POLYURETHANE INSULATION MOLD FOR POUR IN PLACE HEAT SHRINK SLEEVE
 STORE ALL CHEMICALS AT 60°F TO 85°F
 3. DIFFERENCES IN HDPE JACKET OD'S BETWEEN PIECES ARE ACCOMMODATED BY A TAPER ACROSS THE FIELD JOINT

FIELD JOINT, HEAT SHRINK SLEEVE

SCALE NONE


7

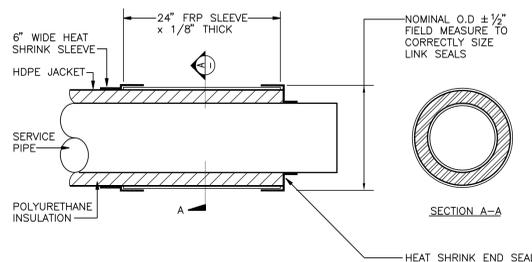

END SEAL ASSEMBLY DETAIL

SCALE NONE

4

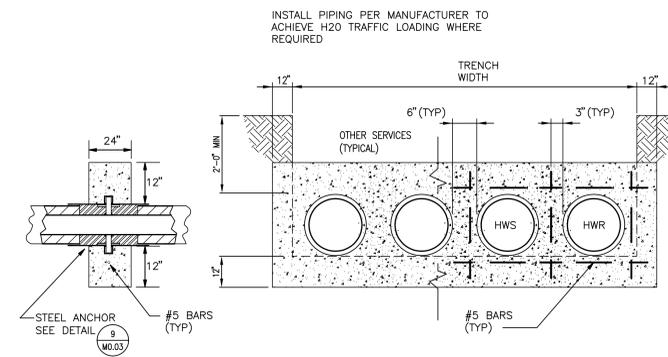


GENERAL NOTES:
 1. MINIMUM 3" COVER FOR ALL REINFORCING
 2. CONCRETE $f'_c=3000$ PSI (MINIMUM)
 3. POUR CONCRETE AGAINST UNDISTURBED EARTH, EXCEPT WHERE FORMED; IF FORMS CREATE VOID, BACKFILL TO 90% MAX. DENSITY

ANCHOR TAG:
 AHCHOR, X.XX
 REPORT #
 POINT NAME

CONCRETE PIPE ANCHOR DETAIL

SCALE NONE

1

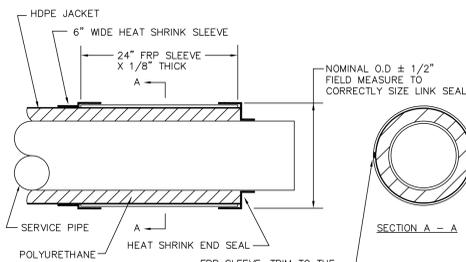


NOTES:
 1. THE FOLLOWING MATERIALS SUPPLIED BY PERMA-PIPE
 FRP SLEEVE
 ADHESIVE
 HEAT SHRINK SLEEVE
 HEAT SHRINK END SEAL

WALL / FLOOR ENTRY END SEAL FIELD KIT

SCALE NONE

8

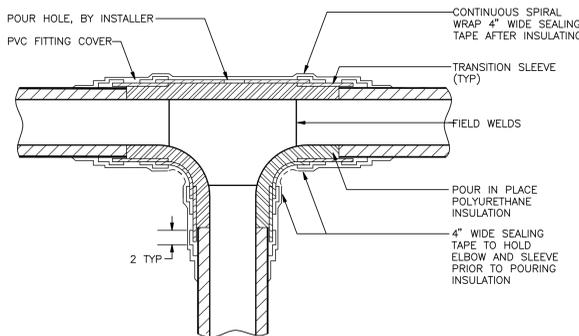


NOTES:
 1. SERVICE PIPE TEES SUPPLIED BY INSTALLER
 2. THE FOLLOWING MATERIALS SUPPLIED BY PERMA-PIPE
 POUR IN PLACE POLYURETHANE INSULATION
 PVC SLEEVES
 PVC FITTING COVER
 SEALING TAPE
 STORE ALL CHEMICALS AT 60°F TO 85°F

STEEL PIPE TEE INSULATION FIELD KIT DETAIL

SCALE NONE

5

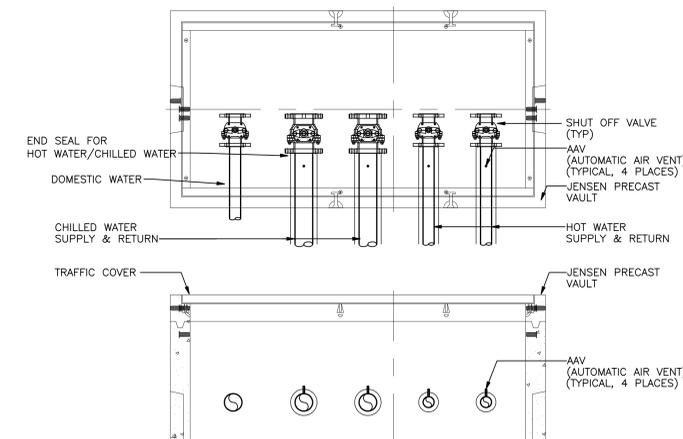


NOTES:
 1. SEE CIVIL DRAWING C2.UO FOR TYPICAL VALVE BOX INSTALLATION.

VALVE BOX AT BUILDING

SCALE NONE

2

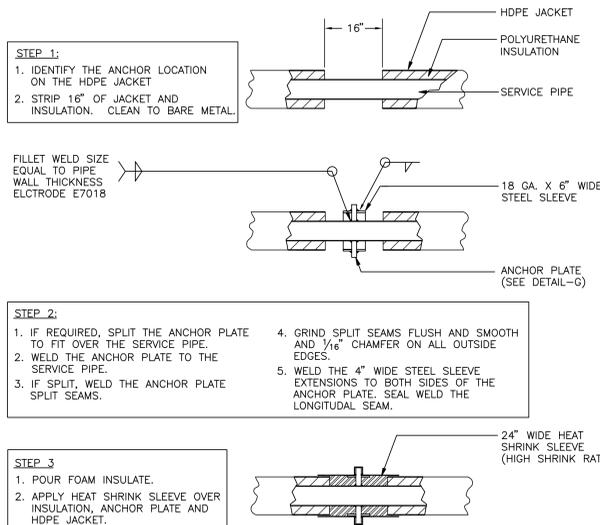

STEP 1:
 1. IDENTIFY THE ANCHOR LOCATION ON THE HDPE JACKET
 2. STRIP 16" OF JACKET AND INSULATION. CLEAN TO BARE METAL

FILLET WELD SIZE EQUAL TO PIPE WALL THICKNESS ELECTRODE E7018

STEP 2:
 1. IF REQUIRED, SPLIT THE ANCHOR PLATE TO FIT OVER THE SERVICE PIPE.
 2. WELD THE ANCHOR PLATE TO THE SERVICE PIPE.
 3. IF SPLIT, WELD THE ANCHOR PLATE SPLIT SEAMS.
 4. GRIND SPLIT SEAMS FLUSH AND SMOOTH AND 1/16" CHAMFER ON ALL OUTSIDE EDGES.
 5. WELD THE 4" WIDE STEEL SLEEVE EXTENSIONS TO BOTH SIDES OF THE ANCHOR PLATE. SEAL WELD THE LONGITUDINAL SEAM.


STEP 3:
 1. POUR FOAM INSULATE.
 2. APPLY HEAT SHRINK SLEEVE OVER INSULATION, ANCHOR PLATE AND HDPE JACKET.

NOTES:
 1. THE FOLLOWING MATERIALS SUPPLIED BY PERMA-PIPE
 STEEL ANCHOR PLATE
 (2) STEEL SLEEVES
 POUR IN PLACE POLYURETHANE INSULATION MOLD FOR POUR IN PLACE HEAT SHRINK SLEEVE (HIGH SHRINK RATIO)
 STORE ALL CHEMICALS AT 60° F TO 85° F

STEEL PIPE STRAIGHT PIPE, ANCHOR FIELD KIT DETAIL

SCALE NONE

9

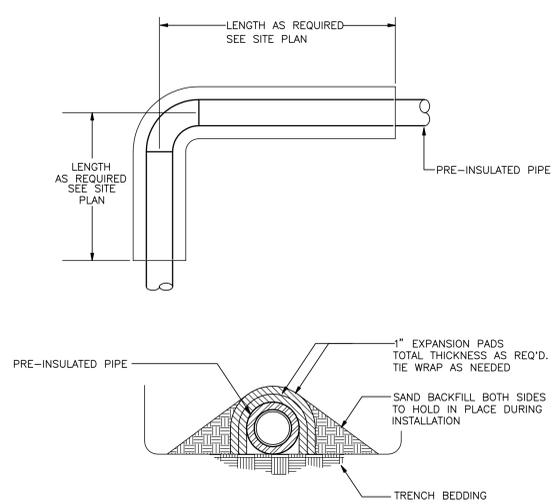

EXTERNAL EXPANSION PADS DETAIL

SCALE NONE

6

VALVE BOX TAG NO.	MFR.	MODEL NO./SIZE	WEIGHT (APPROX.)	REMARKS
VB-1	JENSEN PRECAST	466 VALVE BOX/4'x6'-6"x4'	6,900 LBS.	SEE NOTE 1
VB-2	JENSEN PRECAST	2X2 VALVE BOX/2'x2'x3'	3,335 LBS.	SEE NOTE 2
VB-3	JENSEN PRECAST	4X4 VALVE BOX/4'x4'x3'	5,902 LBS.	SEE NOTE 3

NOTES:
 1. H-20 RATED SLIP RESISTANT GALVANIZED STEEL COVER TORSION ASSIST ADJUSTABLE FRAME.
 2. H-20 TROUGH FRAME HATCH CAST IN FLUSH.
 3. H-20 TROUGH FRAME ALUMINUM HATCH CAST IN FLUSH.

VALVE BOX SCHEDULE

SCALE NONE

3



25555 HESPERIAN BLVD.
 HAYWARD, CALIFORNIA

THE INCORPORATED STATE OF CALIFORNIA REGISTERED PROFESSIONAL ENGINEERS STAMP SERVES AS THE SELF CERTIFICATION FOR THESE DOCUMENTS.



ALL DRAWINGS PREPARED BY SOUTHLAND INDUSTRIES ARE THE EXCLUSIVE PROPERTY OF SOUTHLAND INDUSTRIES AND, UNLESS OTHERWISE AGREED IN WRITING, SOUTHLAND INDUSTRIES SHALL BE DEEMED THE AUTHOR OF THEM AND SHALL RETAIN ALL COMMON LAW, STATUTORY AND OTHER RESERVED RIGHTS. IN ADDITION TO THE COPYRIGHT, ANY USE THEREOF WITHOUT THE EXPRESS WRITTEN CONSENT OF SOUTHLAND INDUSTRIES IS PROHIBITED



NO.	DESCRIPTION	DATE
-	50% CONSTRUCTION DOCUMENTS	08/31/07
-	90% CONSTRUCTION DOCUMENTS	09/21/07
-	ISSUED FOR CONSTRUCTION	11/05/07
-	AS-BUILT	03/06/09

PROJECT TITLE
 CHABOT COMMUNITY COLLEGE CENTRAL PLANT PROJECT

DRAWN BY		CHECKED BY	
PROJECT NO. 5617/065		UNIT SHEET NO.	
SCALE: NONE		SCALE: NONE	
DATE: 04-16-2007		MO.03	

CENTRIFUGAL CHILLER SCHEDULE

MARK	MFR	MODEL	CAPACITY (TONS) (CHW/ICE MAKING)	REFRIG. TYPE	NPLV (CHW/ICE)	(KW/TON) (CHW/ICE MAKING)	EVAPORATOR (CHW/ICE MAKING)					CONDENSER (CHW/ICE MAKING)					ELECTRICAL (CHW/ICE MAKING)				OPER WT (LBS.)	REMARKS
							EWT 'F	LWT 'F	GPM	WPD FT H ₂ O	FOULING FACTOR	EWT 'F	LWT	GPM	WPD FT H ₂ O	FOULING FACTOR	KW	MCA	MOCP	VOLTS-Ø		
CH-1	TRANE	CVHF0650	620/414	R-134A	0.385/0.712	0.570/0.595	52.7/28.3	47.0/21.0	1,480	25.5/25.5	.00010	75/65	87.2/73.3	1,400	17.1/17.8	.00025	330/246	580/450	1000	460V-3Ø	32,000	(1) THROUGH (6)
CH-2	TRANE	CVHF0650	620/414	R-134A	0.385/0.712	0.570/0.595	52.7/28.3	47.0/21.0	1,480	25.5/25.5	.00010	75/65	87.2/73.3	1,400	17.1/17.8	.00025	330/246	580/450	1000	460V-3Ø	32,000	(1) THROUGH (6)

NOTES: (1) DISCONNECT BY OTHERS. (2) PROVIDE VFD. (3) PROVIDE DIFFERENTIAL PRESSURE FLOW SWITCH OR FLOW SENSOR (FACTORY MOUNTED AND WIRED). (4) PROVIDE THIRD PARTY INTERFACE TO ALERTON BUILDING MANAGEMENT SYSTEM. (5) UL LISTED. (6) EVAPORATOR FLUID: 25% ETHELENE GLYCOL. (BY WEIGHT) CONDENSER FLUID: WATER. (7) - (8) - (9) -

COOLING TOWER SCHEDULE

MARK	MFR	MODEL	AIR CFM	WATER				FAN MOTOR				OPERATING WEIGHT (LBS)	REMARKS	
				WB 'F	EWT 'F	LWT 'F	GPM	WTR ΔP FT H ₂ O	QTY	RPM	HP			VOLTS-Ø
CT-1	EVAPCO	REP 224-718	158,445	68	88	75	1,400	5	1	-	50	460V-3Ø	42,500	(1) THROUGH (7)
CT-2	EVAPCO	REP 224-718	158,445											(1) THROUGH (7)

NOTES: (1) STAINLESS STEEL SUMP. (2) EXTERNAL LADDER. (3) 10" EQUALIZER WITH ISOLATION VALVE. (4) VFD WITH BYPASS (INVERTER DUTY MOTOR) IN MECHANICAL YARD. (5) PROVIDE CLEARANCES IN WELL PER MANUFACTURERS RECOMMENDATIONS. (6) EXTERNAL LUBRICATION LINES. (7) PROVIDE VIBRATION CUT-OFF SWITCH. (8) - (9) - (10) - (11) -

COOLING TOWER SEPARATOR

MARK	MFR	MODEL	SERVICE	PUMP					SKID DIMENSIONS (L"xW"xH")	INLET CONN. (IN.)	OUTLET CONN. (IN.)	DRAIN CONN. (IN.)	REMARKS
				FLOW (GPM)	HEAD (FT)	RPM	POWER (HP)	VOLT-Ø					
WT-1	GRISWOLD	CSS-401-HH	CONDENSER WATER	420	80	3500	15	460V-3Ø	36x36x62	4"	4"	1-1/2"	(1) THROUGH (5)

NOTES: (1) PROVIDE ISOLATION VALVES AT INLET, OUTLET AND DRAIN. (2) TEFC MOTOR. (3) PROVIDE 0-160 PSI PRESSURE GAGES AT INLET/OUTLET. (4) NEMA 4 CONTROL PANEL, 460V DISCONNECT, STARTER WITH THERMAL OVERLOAD, HOA SWITCH, AND TIMER FOR PURGE ISOLATION VALVE. (5) PIPING BETWEEN PUMP AND SEPARATOR SHALL BE STEEL. (6) (7) (8) (9)

BOILER SCHEDULE

MARK	MFR	MODEL	TYPE	FLUID	MEDIUM	GPM	INPUT (MBH)	OUTPUT (MBH)	COMB. EFF.	WATER TEMP.		Δ P (FT. W.G.)	GAS PRES. (PSI)	ELECTRICAL		WATER CAPACITY (GAL.)	OPERATING WEIGHT (LBS.)	REMARKS
										ENT. 'F	LVT. 'F			FAN MTR. HP	VOLTS-Ø			
HWB-1	AJAX	WRFG-10500	WATER TUBE FORCED DRAFT	WATER	NATURAL GAS	620	10,500	8,768	85%	150	180	---	1	10	460V-3Ø	545	27,500	(1) THRU (5)
HWB-2	AJAX	WRFG-10500	WATER TUBE FORCED DRAFT	WATER	NATURAL GAS	620	10,500	8,768	85%	150	180	---	1	10	460V-3Ø	545	27,500	(1) THRU (5)
HWB-3	AJAX	WRFG-10500	WATER TUBE FORCED DRAFT	WATER	NATURAL GAS	620	10,500	8,768	85%	150	180	---	1	10	460V-3Ø	545	27,500	(1) THRU (5)

NOTES: (1) BOILERS SHALL BE COMPLETED WITH: - CALIFORNIA APPROVED CONTROLS (CSD-1) - FULL MODULATION BURNER AND COMBUSTION SYSTEM - START/STOP CONTACTS AND FLOW SWITCH - HIGH LIMIT AND LOW WATER CUTOFF W/ RESET AND TEST BUTTON - COMMON ALARM RELAY - FM APPROVED - ASME SAFETY VALVE, COMBINATION PRESS./TEMP. GAUGE. (2) DIVISION 16 SHALL PROVIDE SEPARATE 120V CKT. FOR BOILER CONTROL PANEL. (3) PROVIDE LOW NOx BOILER TO MEET MOST CURRENT BAAQMD REQUIREMENTS. (4) PROVIDE PRE-WIRED AND ASSEMBLED ELECTRONIC BOILER CONTROL PACKAGE INCLUDING STAGING AND LEAD/LAG CONTROLS WITH INTERFACE TO ALERTON BUILDING MANAGEMENT SYSTEM. (5) ON-OFF FIRING. (6) -

WATER TREATMENT SYSTEM (NON-CHEMICAL)

MARK	MFR	MODEL	SERVICE	FLOW (GPM)	INLET CONN. (N.) (PVC)	OUTLET CONN. (N.) (PVC)	WT. (LBS.)	REMARKS
WT-2	CLEARWATER SYSTEMS	DOLPHIN G3120-PVC	CONDENSER WATER	2,800	12	12	250	(1)

NOTES: (1) 230/1/60 POWER T0000 1.8 TRANSFORMER WITHIN CONTROL PANEL.

FAN SCHEDULE

MARK	MFR	MODEL	CFM CONTINUOUS/ EMERGENCY	RPM	TSP	TYPE	BRAKE HP	ELECTRICAL			SERVICE	OPERATING WEIGHT (LBS)	SOUND DATA dBA	REMARKS
								HP	VOLT-Ø	EMERG. POWER (Y/N)				
EF-1	GREENHECK	CUBE-300-50	7500/7500	799	1.0	CENTRIFUGAL UPBLAST	2.2	3.0	460V-3Ø	N	BLDG 2800-CHILLER RM	375	68	(1)

NOTE: (1) PROVIDE ROOF CURB, TIE-DOWNS, ALUMINUM BIRD SCREEN, COUNTER BALANCING BDD. (2) (3) (4)

PLATE HEAT EXCHANGER SCHEDULE

MARK	MFR	MODEL	HOT SIDE					COLD SIDE					PLATE MAT'L	PLATE QTY	# OF PASSES	PLATE THICK (MM)	CONN. SIZE ("HOT / COLD")	WT. (LBS.)	DIMENSIONS ("L"x"W"x"H")	REMARKS
			FLUID	GPM	EWT 'F	LWT 'F	WTR ΔP FT H ₂ O	FLUID	GPM	EWT 'F	LWT 'F	WTR ΔP FT H ₂ O								
HX-1	ARMSTRONG	S-106-2000-197	WATER	1,670	58	44	18.2	ETHYL. GLYCOL	1,460	38.0	54.8	18.3	304 SS	197	1	0.5	8"ø/8"ø	9000	87"x34"x90"	
HX-2	ARMSTRONG	S-106-2000-197	WATER	1,670	58	44	18.2	ETHYL. GLYCOL	1,460	38.0	54.8	18.3	304 SS	197	1	0.5	8"ø/8"ø	9000	87"x34"x90"	
HX-3	ARMSTRONG	S-X13-350-19	WATER	50	215	175	3.2	WATER	120	140	156.5	17.7	304 SS	19	1	0.5	2"ø/2"ø	300	20"x14"x31"	(1)

NOTES: (1) CONTRACTOR SHALL DETERMINE THE SIZE OF HX-3 BASED ON DATA COLLECTED FROM EXISTING CO-GENERATION SYSTEM.

EXPANSION TANK SCHEDULE

MARK	MFR	MODEL	REQUIRED CAPACITY		SERVICE	OPERATING WEIGHT (LBS.)	FILL PRESSURE PSIG	MAXIMUM PRESSURE PSIG	MINIMUM TEMP. (°F)	MAXIMUM TEMP. (°F)	REMARKS
			ACCEPT VOL	TANK VOL							
ET-1	ARMSTRONG	A-300-L	80	80	GLYCOL SYSTEM	1100	12	75	21	60	(1)
ET-2	ARMSTRONG	A-1200-L	317	317	CHILLED WATER SYSTEM	3,400	30	100	42	60	(1)
ET-3	ARMSTRONG	4000-L	1056	1056	HEATING WATER SYSTEM	11,500	30	100	60	180	(1)

NOTES: (1) NPT SYSTEM CONNECTIONS, .302"-.32" CHARGING VALVE, CONSTRUCTED PER ASME BOILER/PRESSURE VESSEL CODE. (2) (3)

AIR SEPARATOR SCHEDULE

MARK	SERVICE	MANUFACTURER MODEL	MIN. GPM	INLET SIZE (IN)	MAX. P.D. (FT. H O ₂)	MAX. OPER. WEIGHT (LBS)	REMARKS
AS-1	GLYCOL SYSTEM	ARMSTRONG VA-12	2800	12	1.8 FT	650	(1)
AS-2	CHILLED WATER SYSTEM	ARMSTRONG VA-12	3340	12	2.0 FT	650	(1)
AS-3	HEATING WATER SYSTEM	ARMSTRONG VA-10	1860	10	2.2 FT	400	(1)

NOTES: (1) WITHOUT STRAINER

GRAVITY INTAKE/RELIEF HOOD SCHEDULE

SYMBOL	MANUFACTURER MODEL	TYPE	LOCATION	SERVICE	AIRFLOW (CFM)	Δ Pa (IN WC)	THROAT AREA (SQ. FT)	THROAT VELOCITY (FFM)	THROAT SIZE (IN)	HOOD SIZE (IN)	OPER WGT (LBS)	REMARKS
GIH-01	GREENHECK GR-42	GRAVITY INTAKE	ROOF	BLDG 2800-CHILLER ROOM	5,000	0.044	12.25	408	42x42	74x72	200	1,2,3

LEGEND: 1. ALUMINUM HOOD 2. BIRDSCREEN 3. ROOF CURB AND DAMPER 4. - 5. - 6. -



25555 HESPERIAN BLVD, HAYWARD, CALIFORNIA

THE INCORPORATED STATE OF CALIFORNIA REGISTERED PROFESSIONAL ENGINEERS STAMP SERVES AS THE SELF CERTIFICATION FOR THESE DOCUMENTS.


SOUTHLAND INDUSTRIES



ALL DRAWINGS PREPARED BY SOUTHLAND INDUSTRIES ARE THE EXCLUSIVE PROPERTY OF SOUTHLAND INDUSTRIES AND, UNLESS OTHERWISE AGREED IN WRITING, SOUTHLAND INDUSTRIES SHALL BE DEEMED THE AUTHOR OF THEM AND SHALL RETAIN ALL COMMON LAW, STATUTORY AND OTHER RESERVED RIGHTS. IN ADDITION TO THE COPYRIGHT, ANY USE THEREOF WITHOUT THE EXPRESS WRITTEN CONSENT OF SOUTHLAND INDUSTRIES IS PROHIBITED



NO.	DESCRIPTION	DATE
0	DSA PERMIT SET	02/21/08
1	DSA BACK CHECK	06/26/08
2	AS BUILT	03/06/09

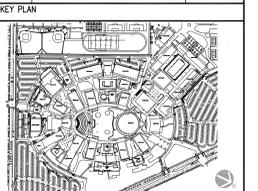

PROJECT TITLE
CHABOT COMMUNITY COLLEGE CENTRAL PLANT
25555 HESPERIAN BLVD, HAYWARD, CALIFORNIA

SHEET TITLE
MECHANICAL SCHEDULES

DRAWN BY	CHECKED BY	UNIT	SHEET NO.
5617065			

SCALE:
DATE 06-26-2008

MHO.3

VARIABLE FREQUENCY DRIVE SCHEDULE											
EQUIPMENT TAG	MFR MODEL	LOCATION	SERVICE	MOTOR SERVICE	ELECTRICAL			ENCLOSURE	BYPASS STARTER	REMARKS	
					MOTOR HP	VFD HP	VOLTAGE				
VFD-1	ABB ACH550-BC-245A-4	MECHANICAL YARD	SCHWP-1	PUMP MOTOR	200	200	460-3-60	NEMA 3R	YES	1,2	
VFD-2	ABB ACH550-BC-245A-4	MECHANICAL YARD	SCHWP-2	PUMP MOTOR	200	200	460-3-60	NEMA 3R	YES	1,2	
VFD-3	ABB ACH550-BC-157A-4	CHILLER ROOM	SHWP-1	PUMP MOTOR	125	125	460-3-60	NEMA 1	YES	1,2	
VFD-4	ABB ACH550-BC-157A-4	CHILLER ROOM	SHWP-2	PUMP MOTOR	125	125	460-3-60	NEMA 1	YES	1,2	
VFD-5	ABB ACH550-CC-072A-4+B058	BOILER ROOM	CT-1	COOLING TOWER FAN MOTOR	50	50	460-3-60	NEMA 1	YES	1,2	
VFD-6	ABB ACH550-CC-072A-4+B058	BOILER ROOM	CT-2	COOLING TOWER FAN MOTOR	50	50	460-3-60	NEMA 1	YES	1,2	
LEGEND:					1. DISCONNECT PROVIDED AND INSTALLED BY OTHERS	2. PROVIDE BACNET INTERFACE FOR ALLERTON BMS	3. -				

CHEMICAL POT FEEDER SCHEDULE									
EQUIPMENT TAG	MANUFACTURER MODEL	SERVICE	LOCATION	INLET CONNECTION SIZE (IN)	OUTLET CONNECTION SIZE (IN)	DRAIN CONNECTION SIZE (IN)	TANK VOLUME (GAL)	OPERATING WEIGHT (LBS)	REMARKS
PF-1	WINGART DB-12HD	CHILLED WATER	CHILLER ROOM	3/4"	3/4"	3/4"	13.28	200	
PF-2	WINGART DB-12HD	HEATING HOT WATER	BOILER ROOM	3/4"	3/4"	3/4"	13.28	200	

ICE THERMAL STORAGE SYSTEM												
MARK	MANUFACTURER MODEL	DISCHARGE FLOW (GPM)	CHARGE FLOW (GPM)	PICK DISCHARGE RATE (TON/HR.)	TANK QTY.	SYSTEM SUPPLY TEMP.	SYSTEM RETURN TEMP.	ICE MAKING CAPACITY (TON)	PRESSURE DROP DISCHARGE (PSI)	GLYCOL CHARGE	ICE MAKING HOURS.	REMARKS
ITS-1	CALMAC - 1500	2965	2965		12	38°F	55°F	70	1.7	25%	8	

GLYCOL FEED SYSTEM										
MARK	MFR	MODEL	SERVICE	TANK CAPACITY (GAL)	COLD FILL PRESSURE (PSI)	MAX. PRESSURE (PSI)	ELECT. SUPPLY	CONN. (IN.)	WT. (LB.)	REMARKS
GFS-1	ARMSTRONG	GLA-U-HP-1	GLYCOL	53	45-90	150	120/1/60	1/2	160	
NOTES: (1) -										

ANCHORING / VIBRATION ISOLATION SCHEDULE						
EQUIPMENT	EQUIPMENT TAG	BASE AND INSULATION		ANCHOR DETAIL	REMARKS	
		MNFR.	MODEL			
CHILLER	CH-1, CH-2	-	NEOPRENE PADS	SEE STRUCTURAL DWGS	1, 2	
COOLING TOWER	CT-1, CT-2	-	NEOPRENE PADS	SEE STRUCTURAL DWGS	1, 2	
BOILER	HWB-1, HWB-2, HWB-3	-	NEOPRENE PADS	SEE STRUCTURAL DWGS	1, 2	
SEPARATOR	WT-1	-	NEOPRENE PADS	SEE STRUCTURAL DWGS	1, 2	
PUMPS	CHWP-1 & 2, CWP-1 & 2, SCHWP-1 & 2, HWP-1, 2 & 3, SHWP-1 & 2, HWP-4	-	N/A	SEE STRUCTURAL DWGS		
EXPANSION TANK	ET-1, 2 & 3	-	NONE			
HEAT EXCHANGER	HX-1, 2 & 3	-	NONE			
EXHAUST FAN	EF-1	-	N/A	SEE MECHANICAL DETAIL SHEET		
POT FEEDER	PF-1 & 2	-	NONE			
LEGEND:						
1.	SEISMIC BRACE UNIT PER SMACNA GUIDELINES.					
2.	PADS FOR EQUIPMENT MUST HAVE GROMMENTS SIMILAR TO MASON HG.					
3.						
4.						
5.						



25555 HESPERIAN BLVD,
HAYWARD, CALIFORNIA

THE INCORPORATED STATE OF CALIFORNIA REGISTERED PROFESSIONAL ENGINEERS STAMP SERVES AS THE SELF CERTIFICATION FOR THESE DOCUMENTS.


SOUTHLAND INDUSTRIES



ALL DRAWINGS PREPARED BY SOUTHLAND INDUSTRIES ARE THE EXCLUSIVE PROPERTY OF SOUTHLAND INDUSTRIES AND, UNLESS OTHERWISE AGREED IN WRITING, SOUTHLAND INDUSTRIES SHALL BE DEEMED THE AUTHOR OF THEM AND SHALL RETAIN ALL COMMON LAW, STATUTORY AND OTHER RESERVED RIGHTS. IN ADDITION TO THE COPYRIGHT, ANY USE THEREOF WITHOUT THE EXPRESS WRITTEN CONSENT OF SOUTHLAND INDUSTRIES IS PROHIBITED




NO.	DESCRIPTION	DATE
0	DSA PERMIT SET	02/21/08
1	DSA BACK CHECK	06/26/08
2	AS BUILT	03/06/09

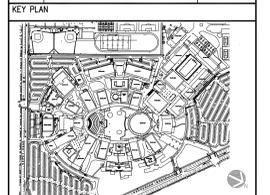

PROJECT TITLE
CHABOT COMMUNITY COLLEGE CENTRAL PLANT
25555 HESPERIAN BLVD,
HAYWARD, CALIFORNIA

SHEET TITLE
MECHANICAL SCHEDULES


PROJECT NO. 5617065	SCALE:	DATE 06-26-2008	DRAWN BY	CHECKED BY	UNIT	SHEET NO.
						MHO.4

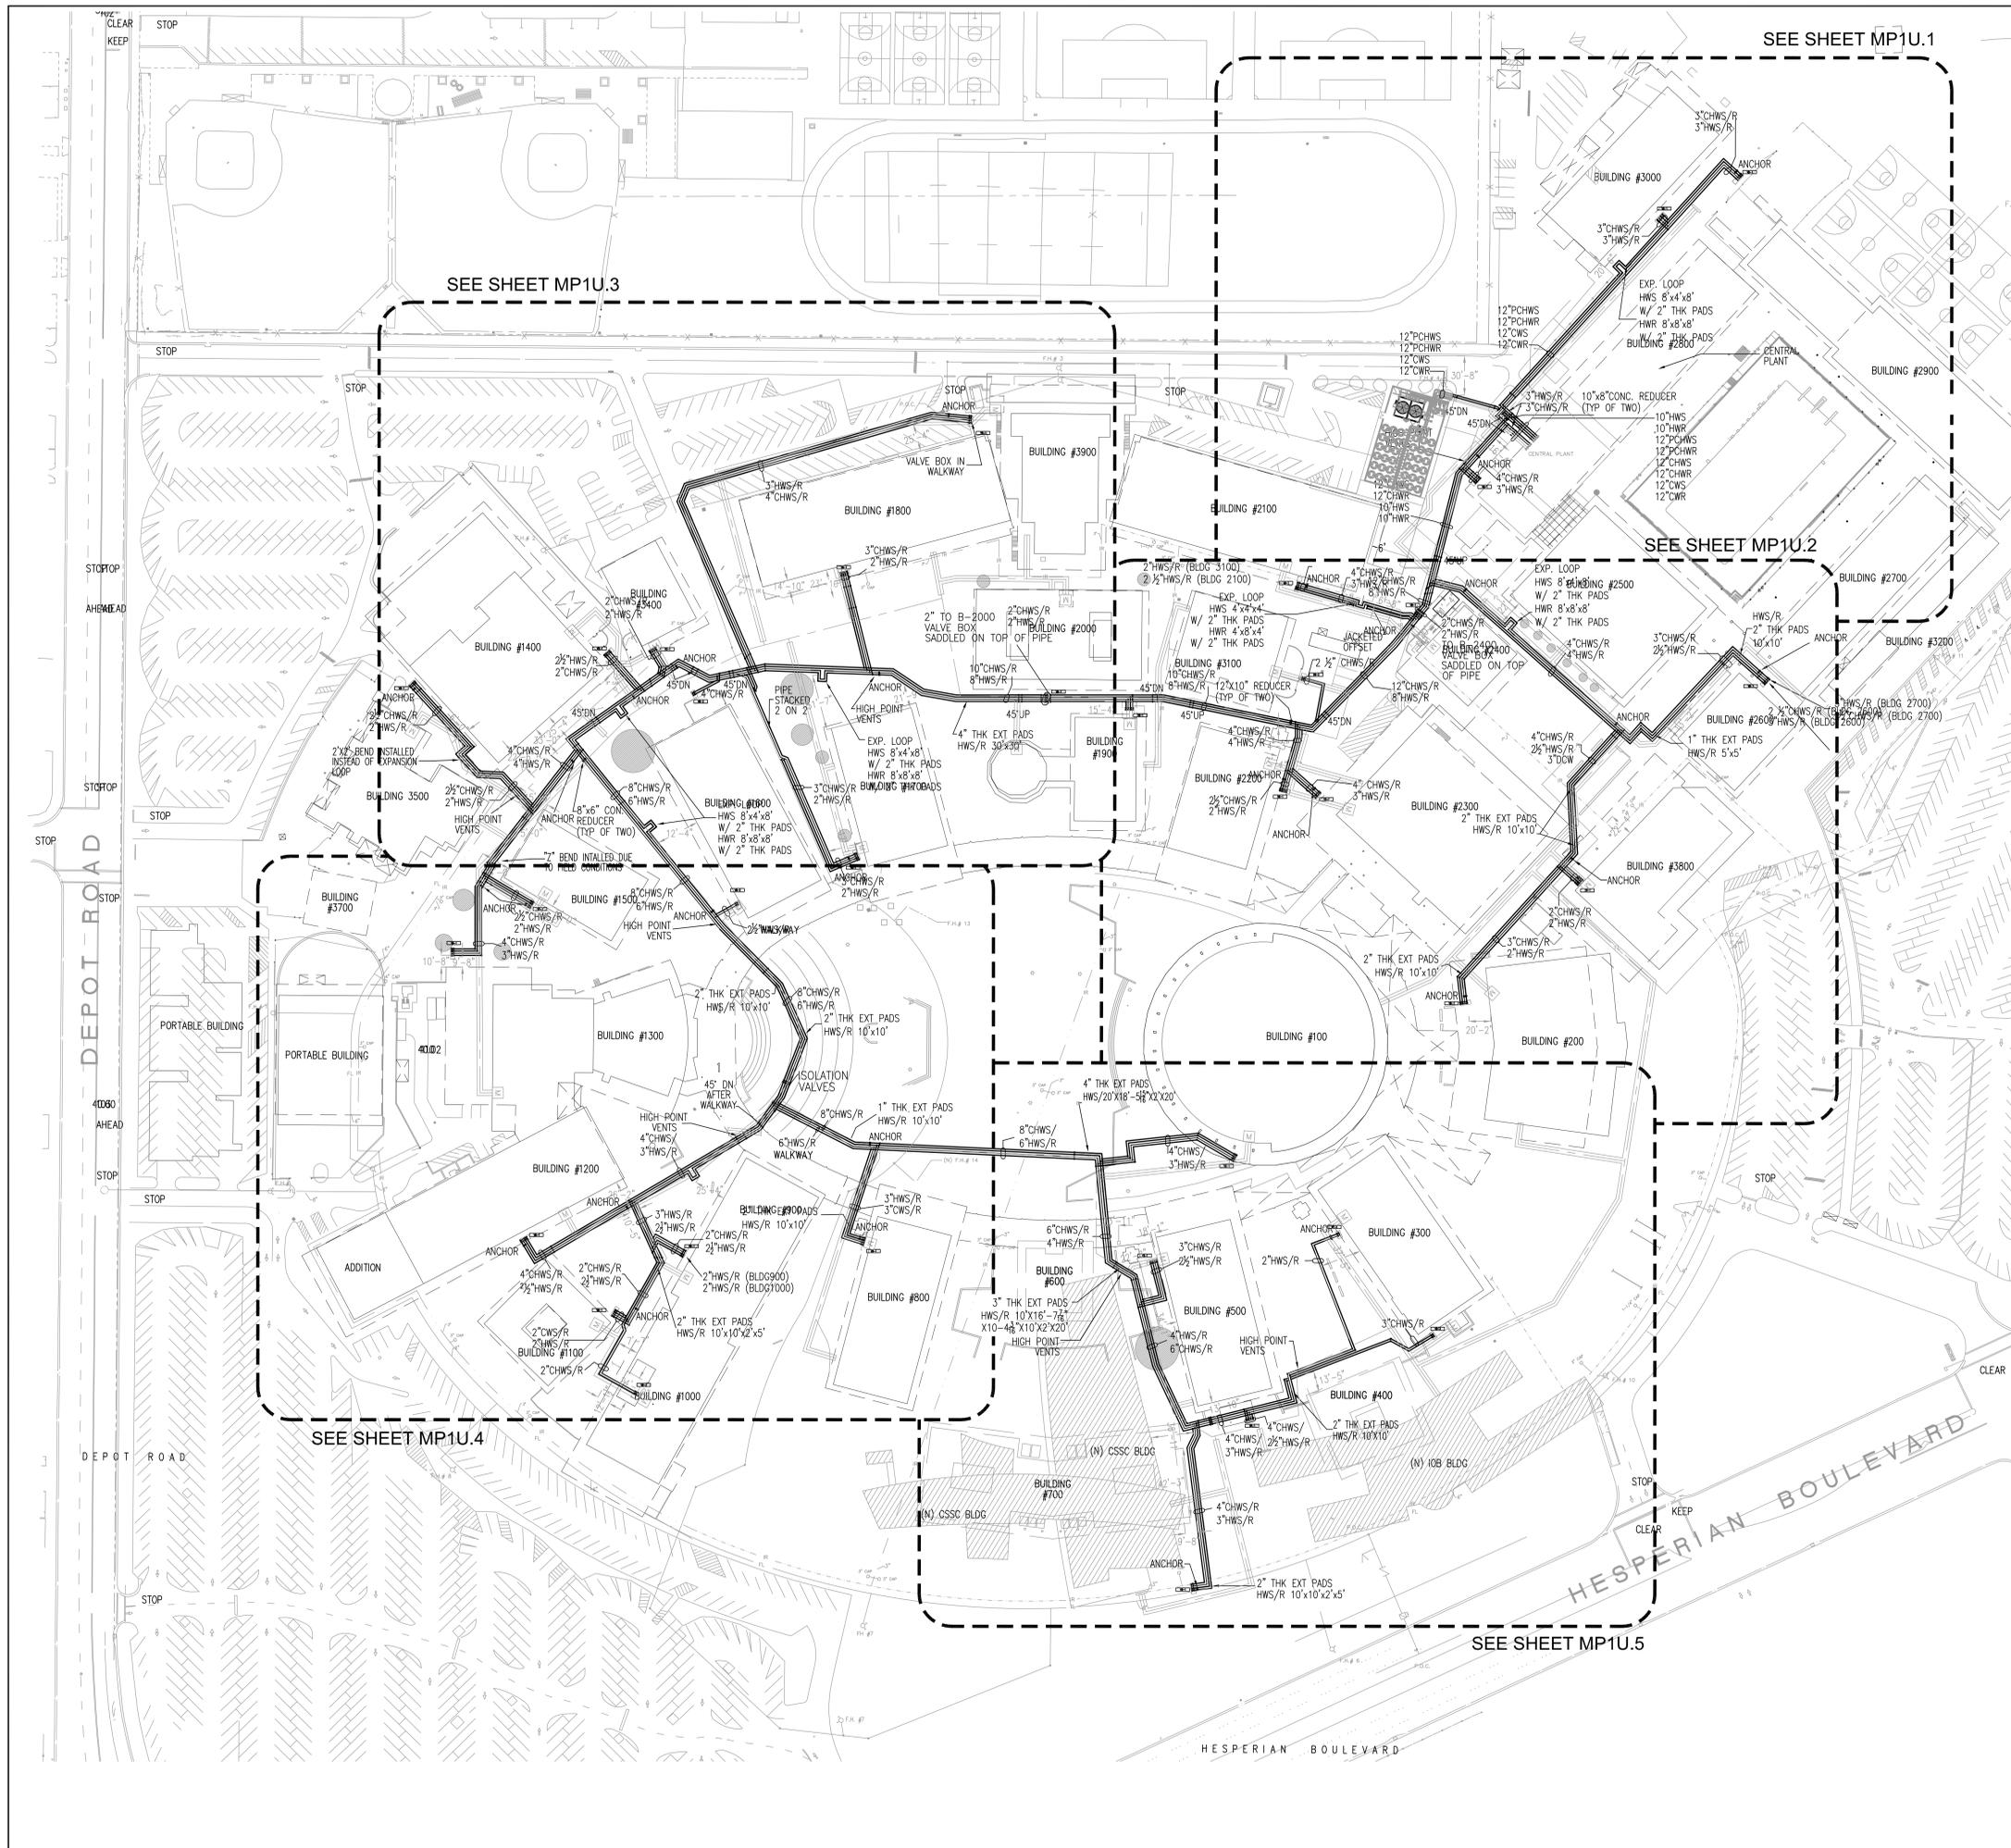

SHEET KEYNOTES

GENERAL NOTES

- A. VB-1 6'-6"x4' VALVE BOX
- B. VB-3 4'x4' VALVE BOX

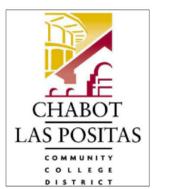

25555 HESPERIAN BLVD,
HAYWARD, CALIFORNIA

THE INCORPORATED STATE OF CALIFORNIA REGISTERED PROFESSIONAL ENGINEERS STAMP SERVES AS THE SELF CERTIFICATION FOR THESE DOCUMENTS.

SOUTHLAND INDUSTRIES




775 Commercial Street
San Jose, CA 95112
Tel: 408.970.3777
Fax: 408.970.3776

ALL DRAWINGS PREPARED BY SOUTHLAND INDUSTRIES ARE THE EXCLUSIVE PROPERTY OF SOUTHLAND INDUSTRIES AND, UNLESS OTHERWISE AGREED IN WRITING, SOUTHLAND INDUSTRIES SHALL BE DEEMED THE AUTHOR OF THEM AND SHALL RETAIN ALL COMMON LAW, STATUTORY AND OTHER RESERVED RIGHTS. IN ADDITION TO THE COPYRIGHT, ANY USE THEREOF WITHOUT THE EXPRESS WRITTEN CONSENT OF SOUTHLAND INDUSTRIES IS PROHIBITED



NO.	DESCRIPTION	DATE
-	50% CONSTRUCTION DOCUMENTS	06/31/07
-	90% CONSTRUCTION DOCUMENTS	09/21/07
-	ISSUED FOR CONSTRUCTION	11/05/07
-	AS-BUILT	03/06/09

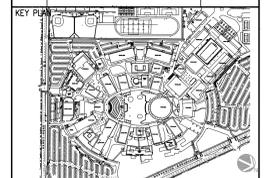

PROJECT TITLE
CHABOT COMMUNITY COLLEGE
CENTRAL PLANT PROJECT

SHEET TITLE
HYDRONIC PIPING OVERALL SITE PLAN

DRAWN BY PROJECT NO. 5617065	CHECKED BY	UNIT	SHEET NO.
SCALE: 1"=60'			MP1U.0
DATE 04-16-2007			



25555 HESPERIAN BLVD,
HAYWARD, CALIFORNIA


THE INCORPORATED STATE OF CALIFORNIA REGISTERED PROFESSIONAL ENGINEERS STAMP SERVES AS THE SELF CERTIFICATION FOR THESE DOCUMENTS.

SOUTHLAND INDUSTRIES
 775 Commercial Street
 San Jose, CA 95112
 Tel: 408-970-3777
 Fax: 408-970-3776

ALL DRAWINGS PREPARED BY SOUTHLAND INDUSTRIES ARE THE EXCLUSIVE PROPERTY OF SOUTHLAND INDUSTRIES AND, UNLESS OTHERWISE AGREED IN WRITING, SOUTHLAND INDUSTRIES SHALL BE DEEMED THE AUTHOR OF THEM AND SHALL RETAIN ALL COMMON LAW, STATUTORY AND OTHER RESERVED RIGHTS. IN ADDITION TO THE COPYRIGHT, ANY USE THEREOF WITHOUT THE EXPRESS WRITTEN CONSENT OF SOUTHLAND INDUSTRIES IS PROHIBITED




NO.	DESCRIPTION	DATE
-	50% CONSTRUCTION DOCUMENTS	08/31/07
-	90% CONSTRUCTION DOCUMENTS	09/21/07
-	ISSUED FOR CONSTRUCTION	11/05/07
-	AS-BUILT	03/06/09

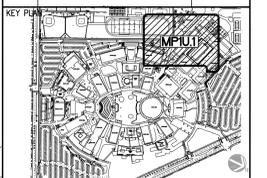


PROJECT TITLE
CHABOT COMMUNITY COLLEGE
CENTRAL PLANT PROJECT

SHEET TITLE
PARTIAL HYDRONIC PIPING PLAN

DRAWN BY PROJECT NO. 5617065	CHECKED BY UNIT SHEET NO.
SCALE: 1"=20'	MP1U.1
DATE 04-16-2007	

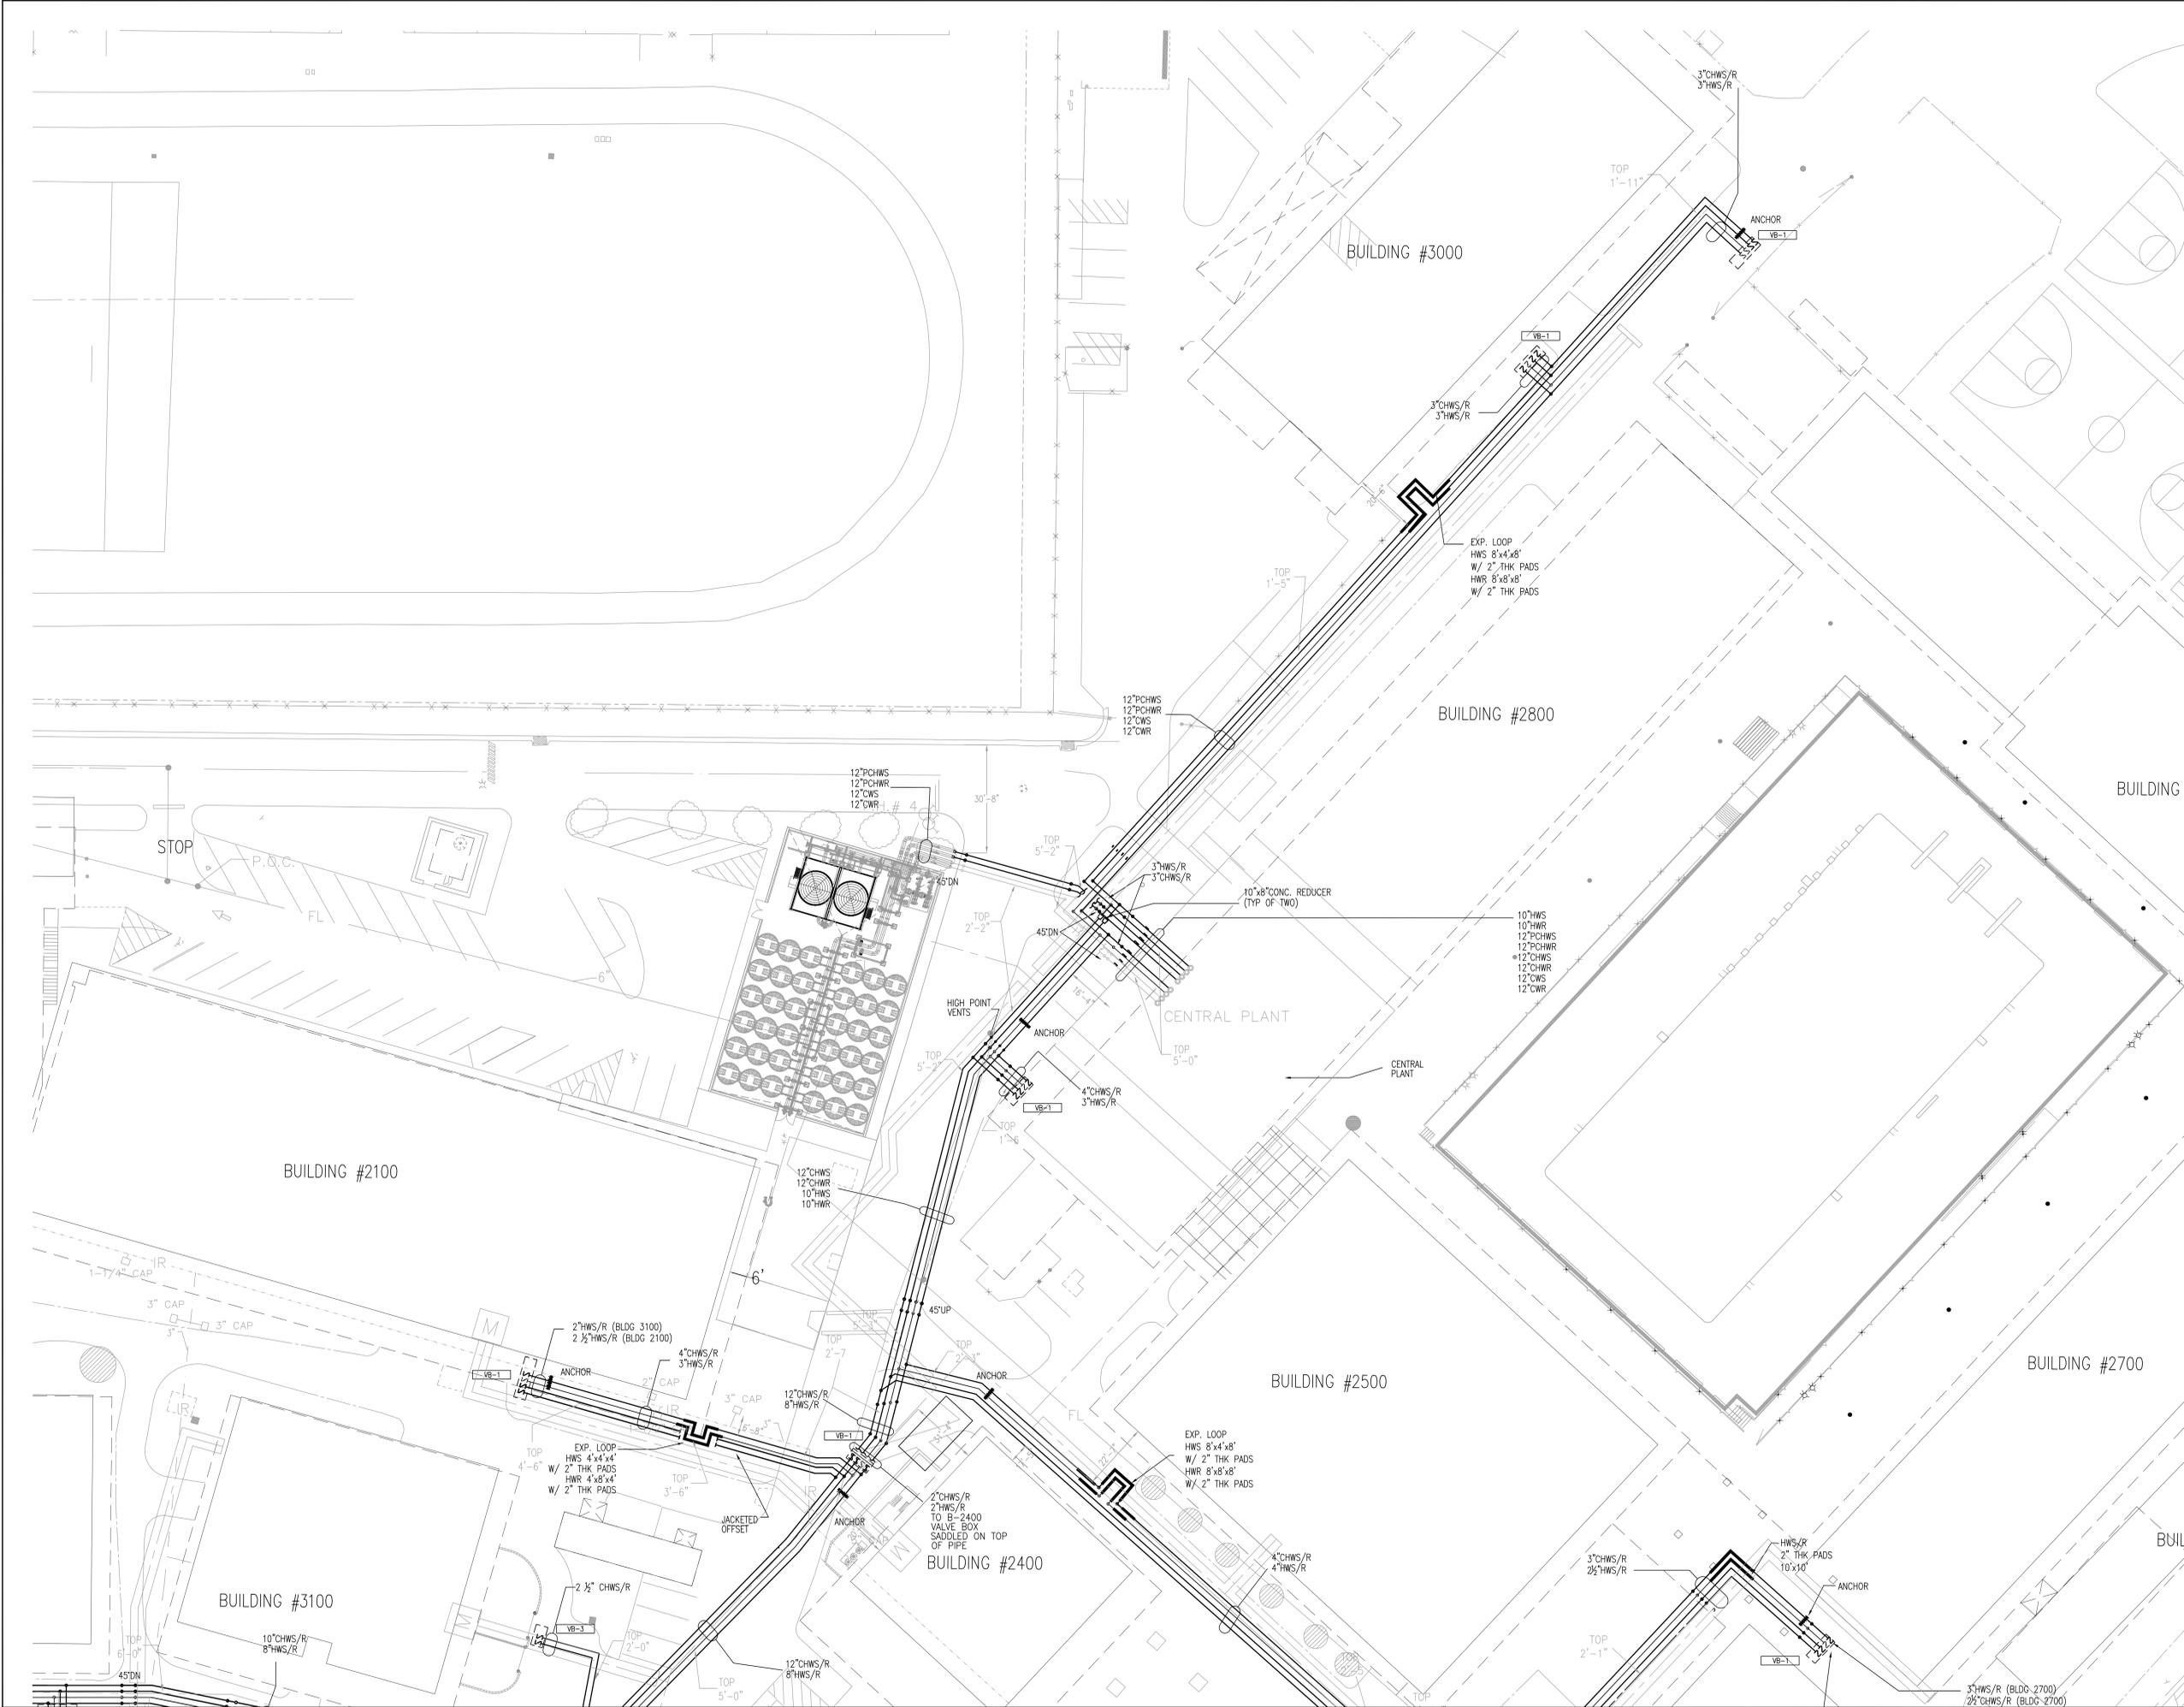

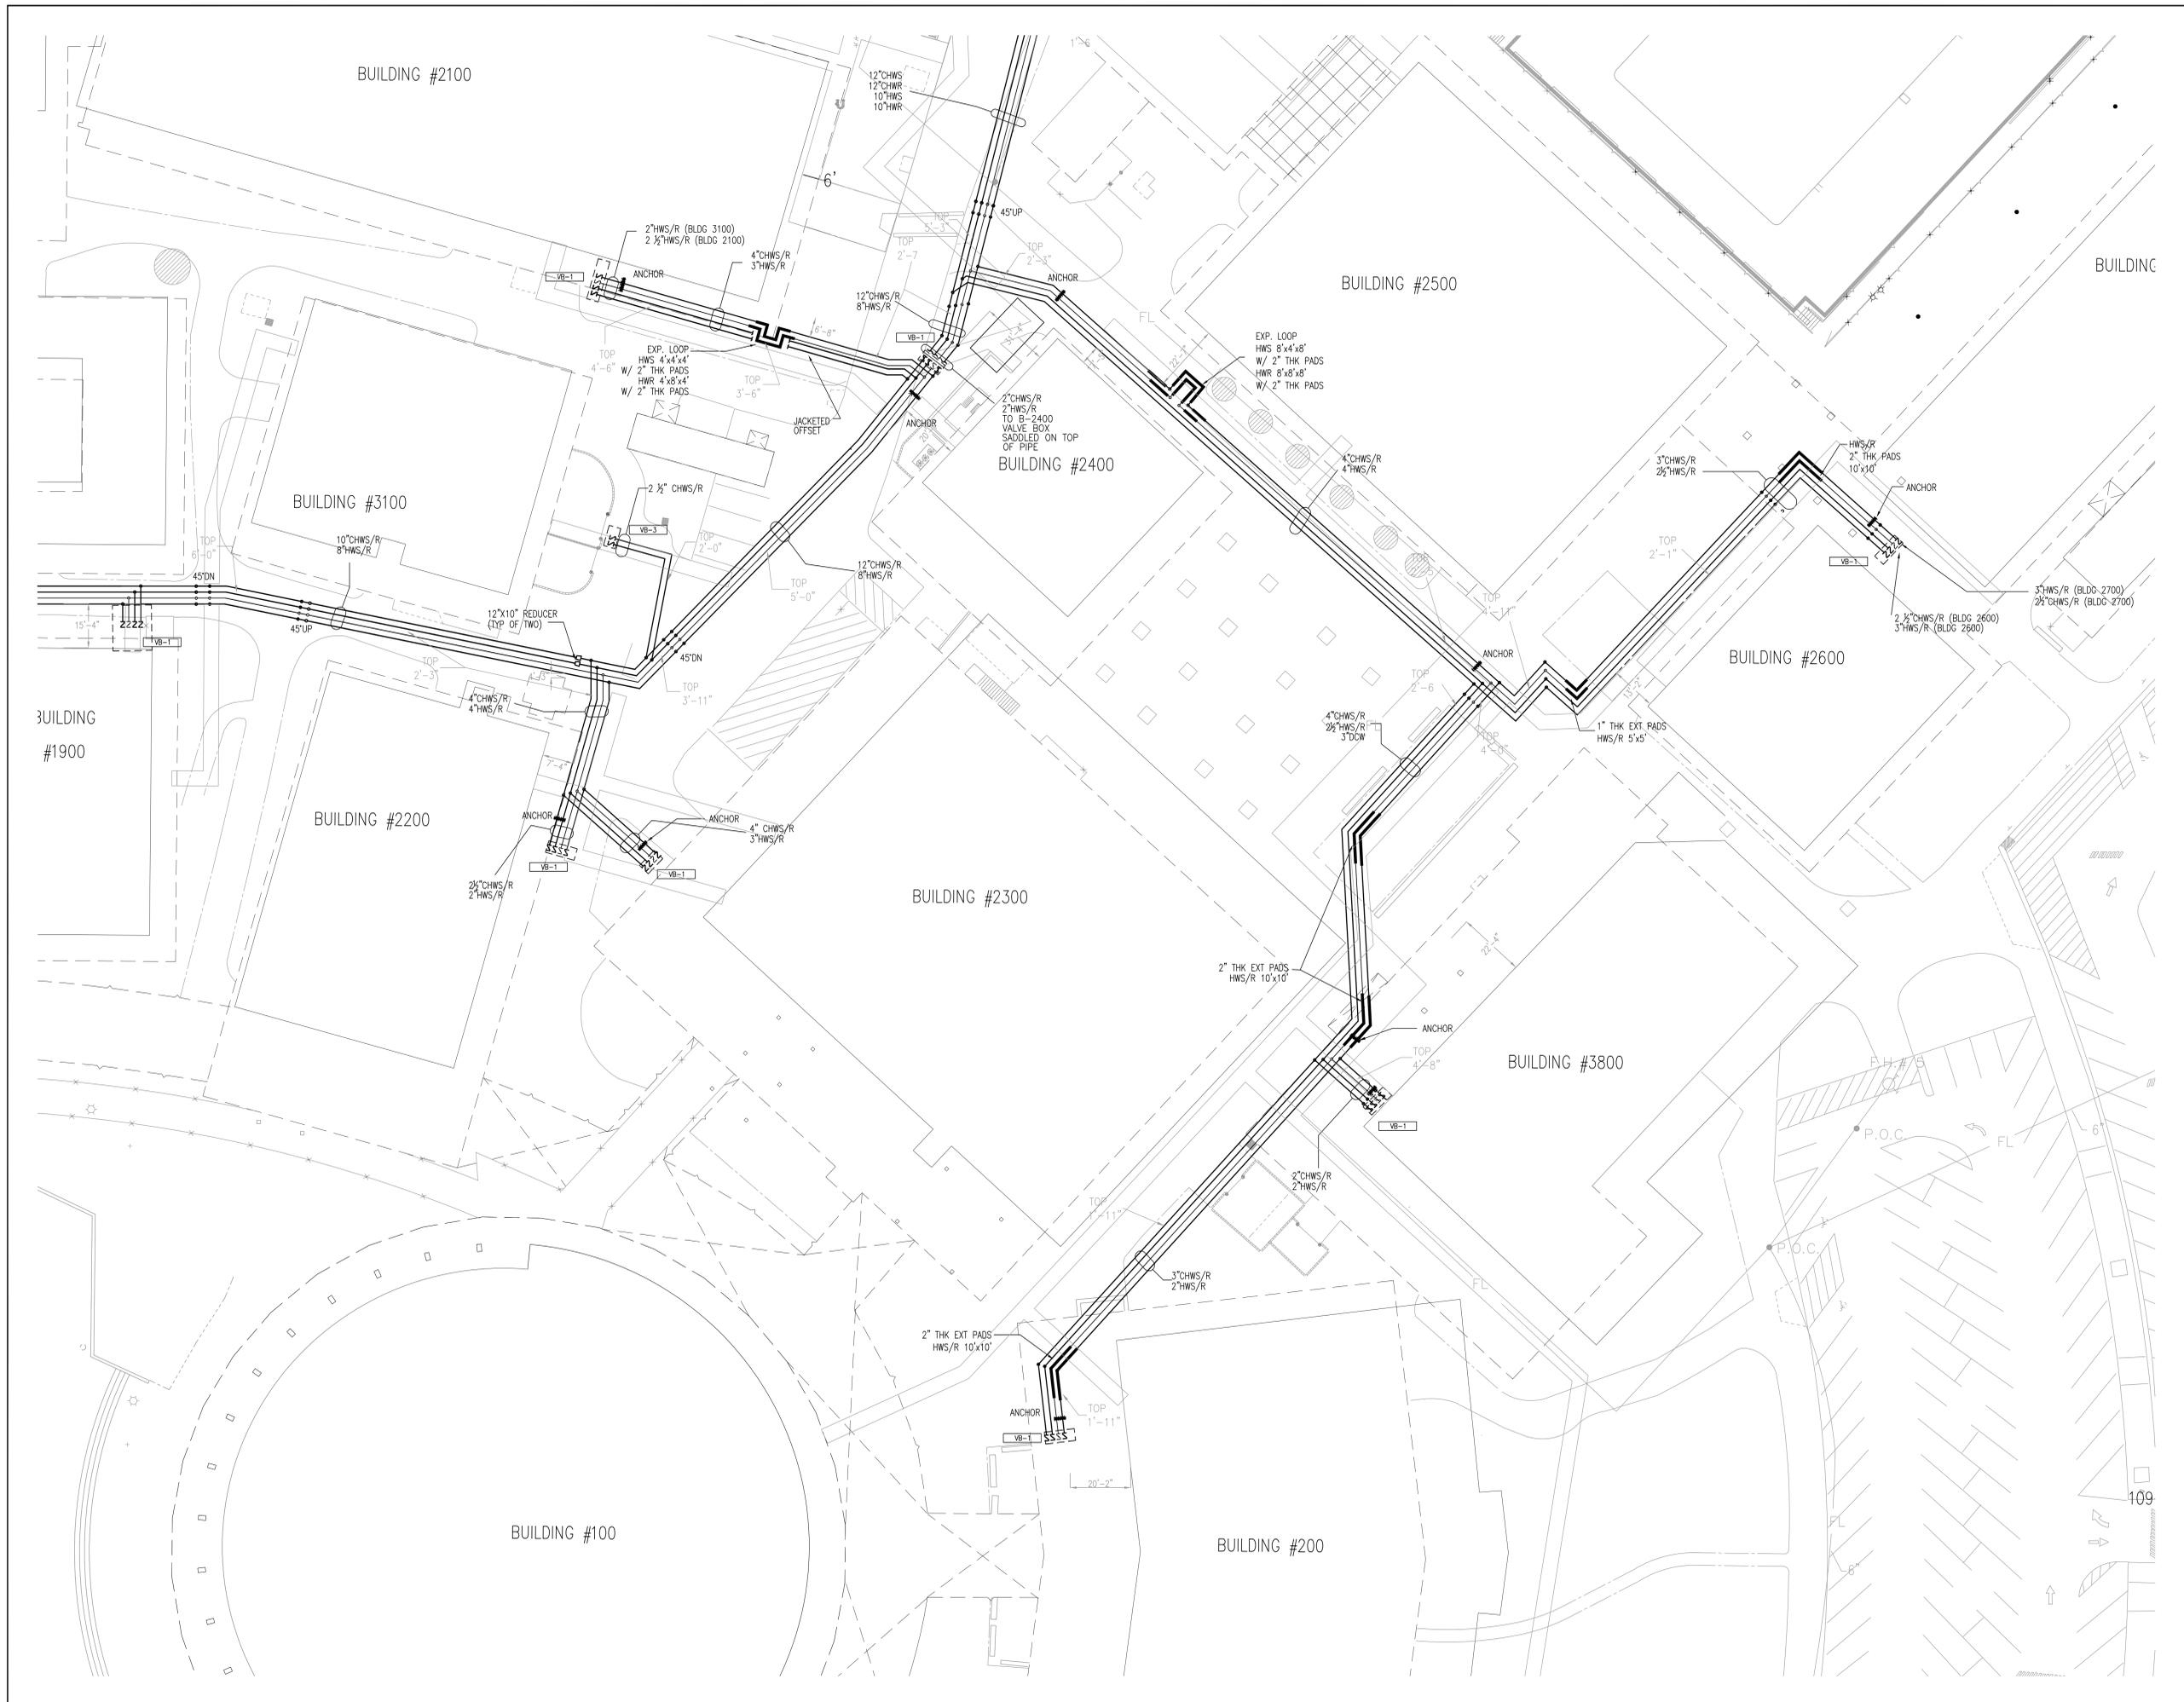

25555 HESPERIAN BLVD,
HAYWARD, CALIFORNIA


THE INCORPORATED STATE OF CALIFORNIA REGISTERED PROFESSIONAL ENGINEERS STAMP SERVES AS THE SELF CERTIFICATION FOR THESE DOCUMENTS.

SOUTHLAND INDUSTRIES
 775 Commercial Street
 San Jose, CA 95112
 Tel: 408-970-3777
 Fax: 408-970-3776

ALL DRAWINGS PREPARED BY SOUTHLAND INDUSTRIES ARE THE EXCLUSIVE PROPERTY OF SOUTHLAND INDUSTRIES AND, UNLESS OTHERWISE AGREED IN WRITING, SOUTHLAND INDUSTRIES SHALL BE DEEMED THE AUTHOR OF THEM AND SHALL RETAIN ALL COMMON LAW, STATUTORY AND OTHER RESERVED RIGHTS. IN ADDITION TO THE COPYRIGHT, ANY USE THEREOF WITHOUT THE EXPRESS WRITTEN CONSENT OF SOUTHLAND INDUSTRIES IS PROHIBITED




NO.	DESCRIPTION	DATE
-	50% CONSTRUCTION DOCUMENTS	08/31/07
-	90% CONSTRUCTION DOCUMENTS	09/21/07
-	ISSUED FOR CONSTRUCTION	11/05/07
-	AS-BUILT	03/06/09

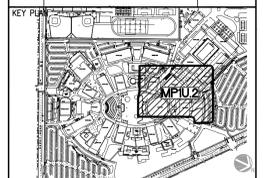

PROJECT TITLE
 CHABOT COMMUNITY COLLEGE
 CENTRAL PLANT PROJECT

SHEET TITLE
 PARTIAL HYDRONIC PIPING PLAN

DRAWN BY	CHECKED BY
PROJECT NO. 5617065	UNIT
SCALE: 1"=20'	SHEET NO. MPIU.2
DATE 04-16-2007	

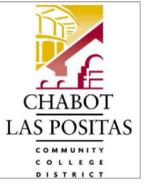

25555 HESPERIAN BLVD,
HAYWARD, CALIFORNIA


THE INCORPORATED STATE OF CALIFORNIA REGISTERED PROFESSIONAL ENGINEERS STAMP SERVES AS THE SELF CERTIFICATION FOR THESE DOCUMENTS.

SOUTHLAND INDUSTRIES
 775 Commercial Street
 San Jose, CA 95112
 Tel: 408-970-3777
 Fax: 408-970-3776

ALL DRAWINGS PREPARED BY SOUTHLAND INDUSTRIES ARE THE EXCLUSIVE PROPERTY OF SOUTHLAND INDUSTRIES AND, UNLESS OTHERWISE AGREED IN WRITING, SOUTHLAND INDUSTRIES SHALL BE DEEMED THE AUTHOR OF THEM AND SHALL RETAIN ALL COMMON LAW, STATUTORY AND OTHER RESERVED RIGHTS. IN ADDITION TO THE COPYRIGHT, ANY USE THEREOF WITHOUT THE EXPRESS WRITTEN CONSENT OF SOUTHLAND INDUSTRIES IS PROHIBITED




NO.	DESCRIPTION	DATE
-	50% CONSTRUCTION DOCUMENTS	08/31/07
-	90% CONSTRUCTION DOCUMENTS	09/21/07
-	ISSUED FOR CONSTRUCTION	11/05/07
-	AS-BUILT	03/06/09

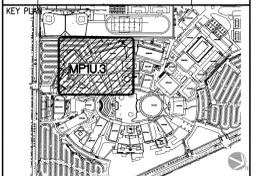

PROJECT TITLE
CHABOT COMMUNITY COLLEGE
CENTRAL PLANT PROJECT

SHEET TITLE
PARTIAL HYDRONIC PIPING PLAN

DRAWN BY PROJECT NO. 5617065	UNIT	CHECKED BY	SHEET NO.
SCALE: 1"=20'			MP1U.3
DATE 04-16-2007			

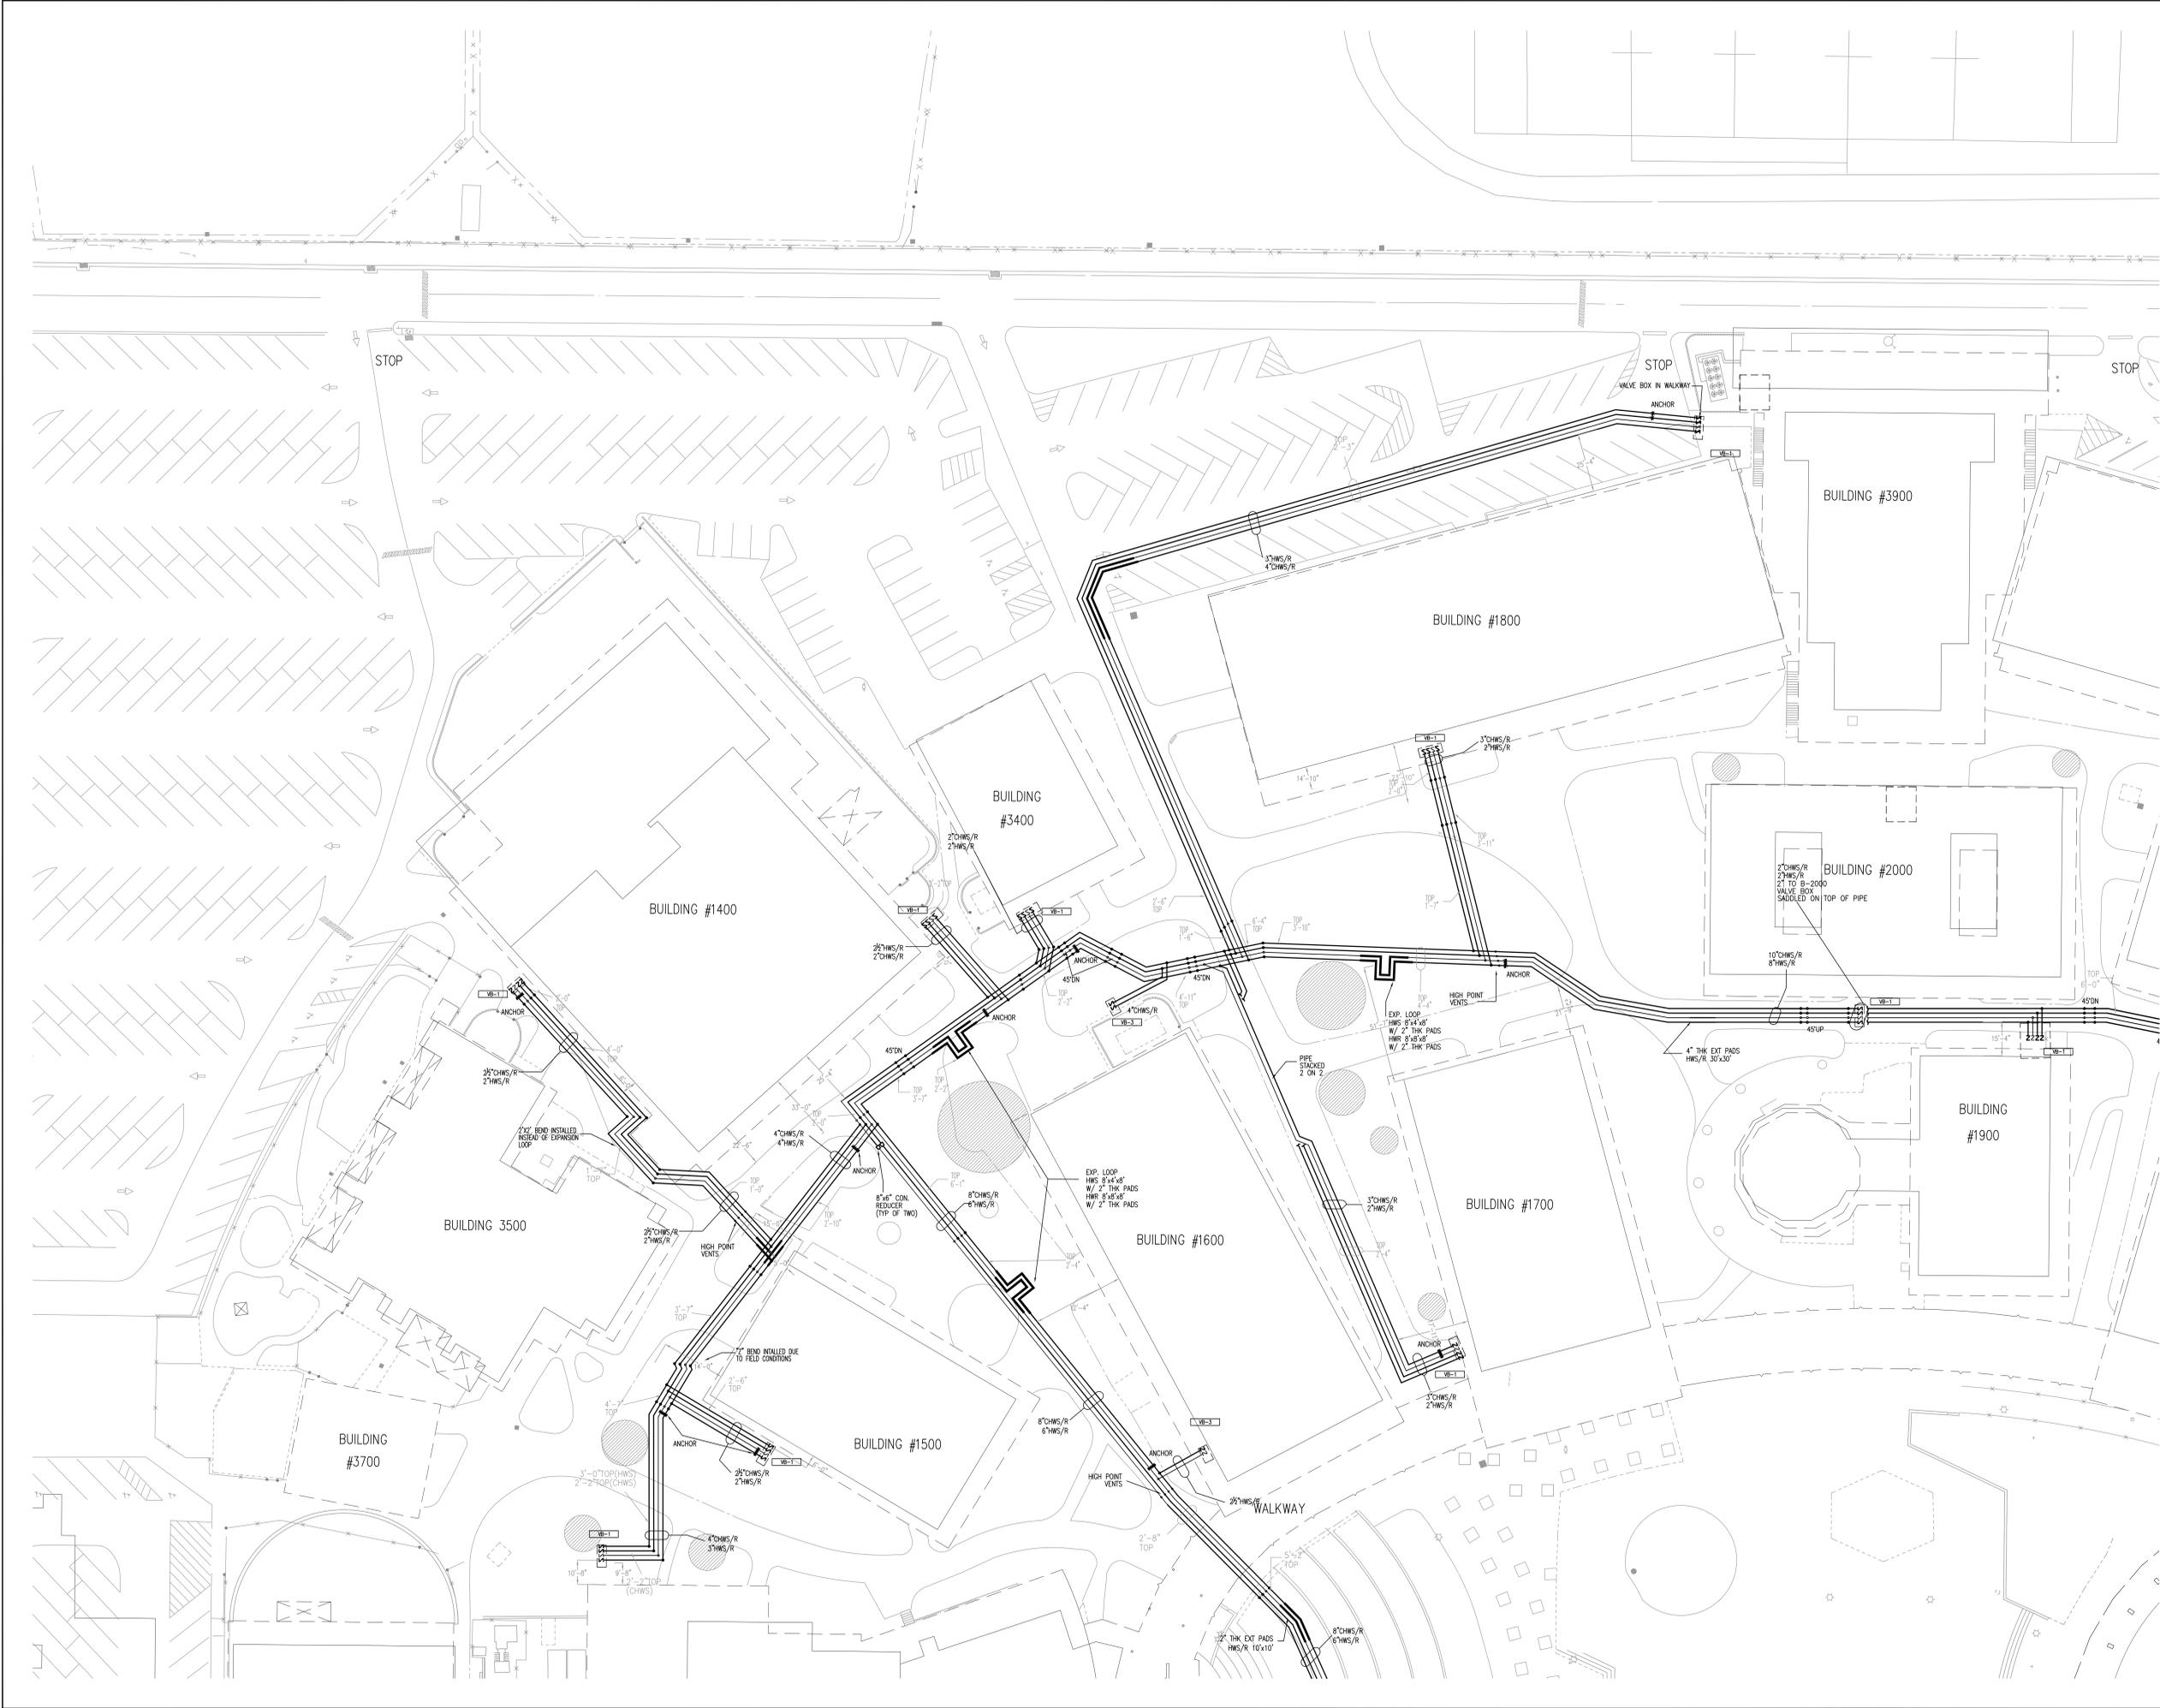



25555 HESPERIAN BLVD,
HAYWARD, CALIFORNIA

THE INCORPORATED STATE OF CALIFORNIA REGISTERED PROFESSIONAL ENGINEERS STAMP SERVES AS THE SELF CERTIFICATION FOR THESE DOCUMENTS.

SOUTHLAND INDUSTRIES




775 Commercial Street
San Jose, CA 95112
Tel: 408-970.3777
Fax: 408-970.3776

ALL DRAWINGS PREPARED BY SOUTHLAND INDUSTRIES ARE THE EXCLUSIVE PROPERTY OF SOUTHLAND INDUSTRIES AND, UNLESS OTHERWISE AGREED IN WRITING, SOUTHLAND INDUSTRIES SHALL BE DEEMED THE AUTHOR OF THEM AND SHALL RETAIN ALL COMMON LAW, STATUTORY AND OTHER RESERVED RIGHTS. IN ADDITION TO THE COPYRIGHT, ANY USE THEREOF WITHOUT THE EXPRESS WRITTEN CONSENT OF SOUTHLAND INDUSTRIES IS PROHIBITED




NO.	DESCRIPTION	DATE
-	50% CONSTRUCTION DOCUMENTS	06/31/07
-	90% CONSTRUCTION DOCUMENTS	09/21/07
-	ISSUED FOR CONSTRUCTION	11/05/07
-	AS-BUILT	03/06/09

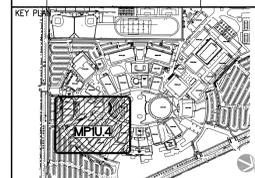


PROJECT TITLE
CHABOT COMMUNITY COLLEGE
CENTRAL PLANT PROJECT

SHEET TITLE
PARTIAL HYDRONIC PIPING PLAN

DRAWN BY	CHECKED BY
PROJECT NO. 5617065	UNIT
SCALE: 1"=20'	SHEET NO. MPIU.4
DATE 04-16-2007	

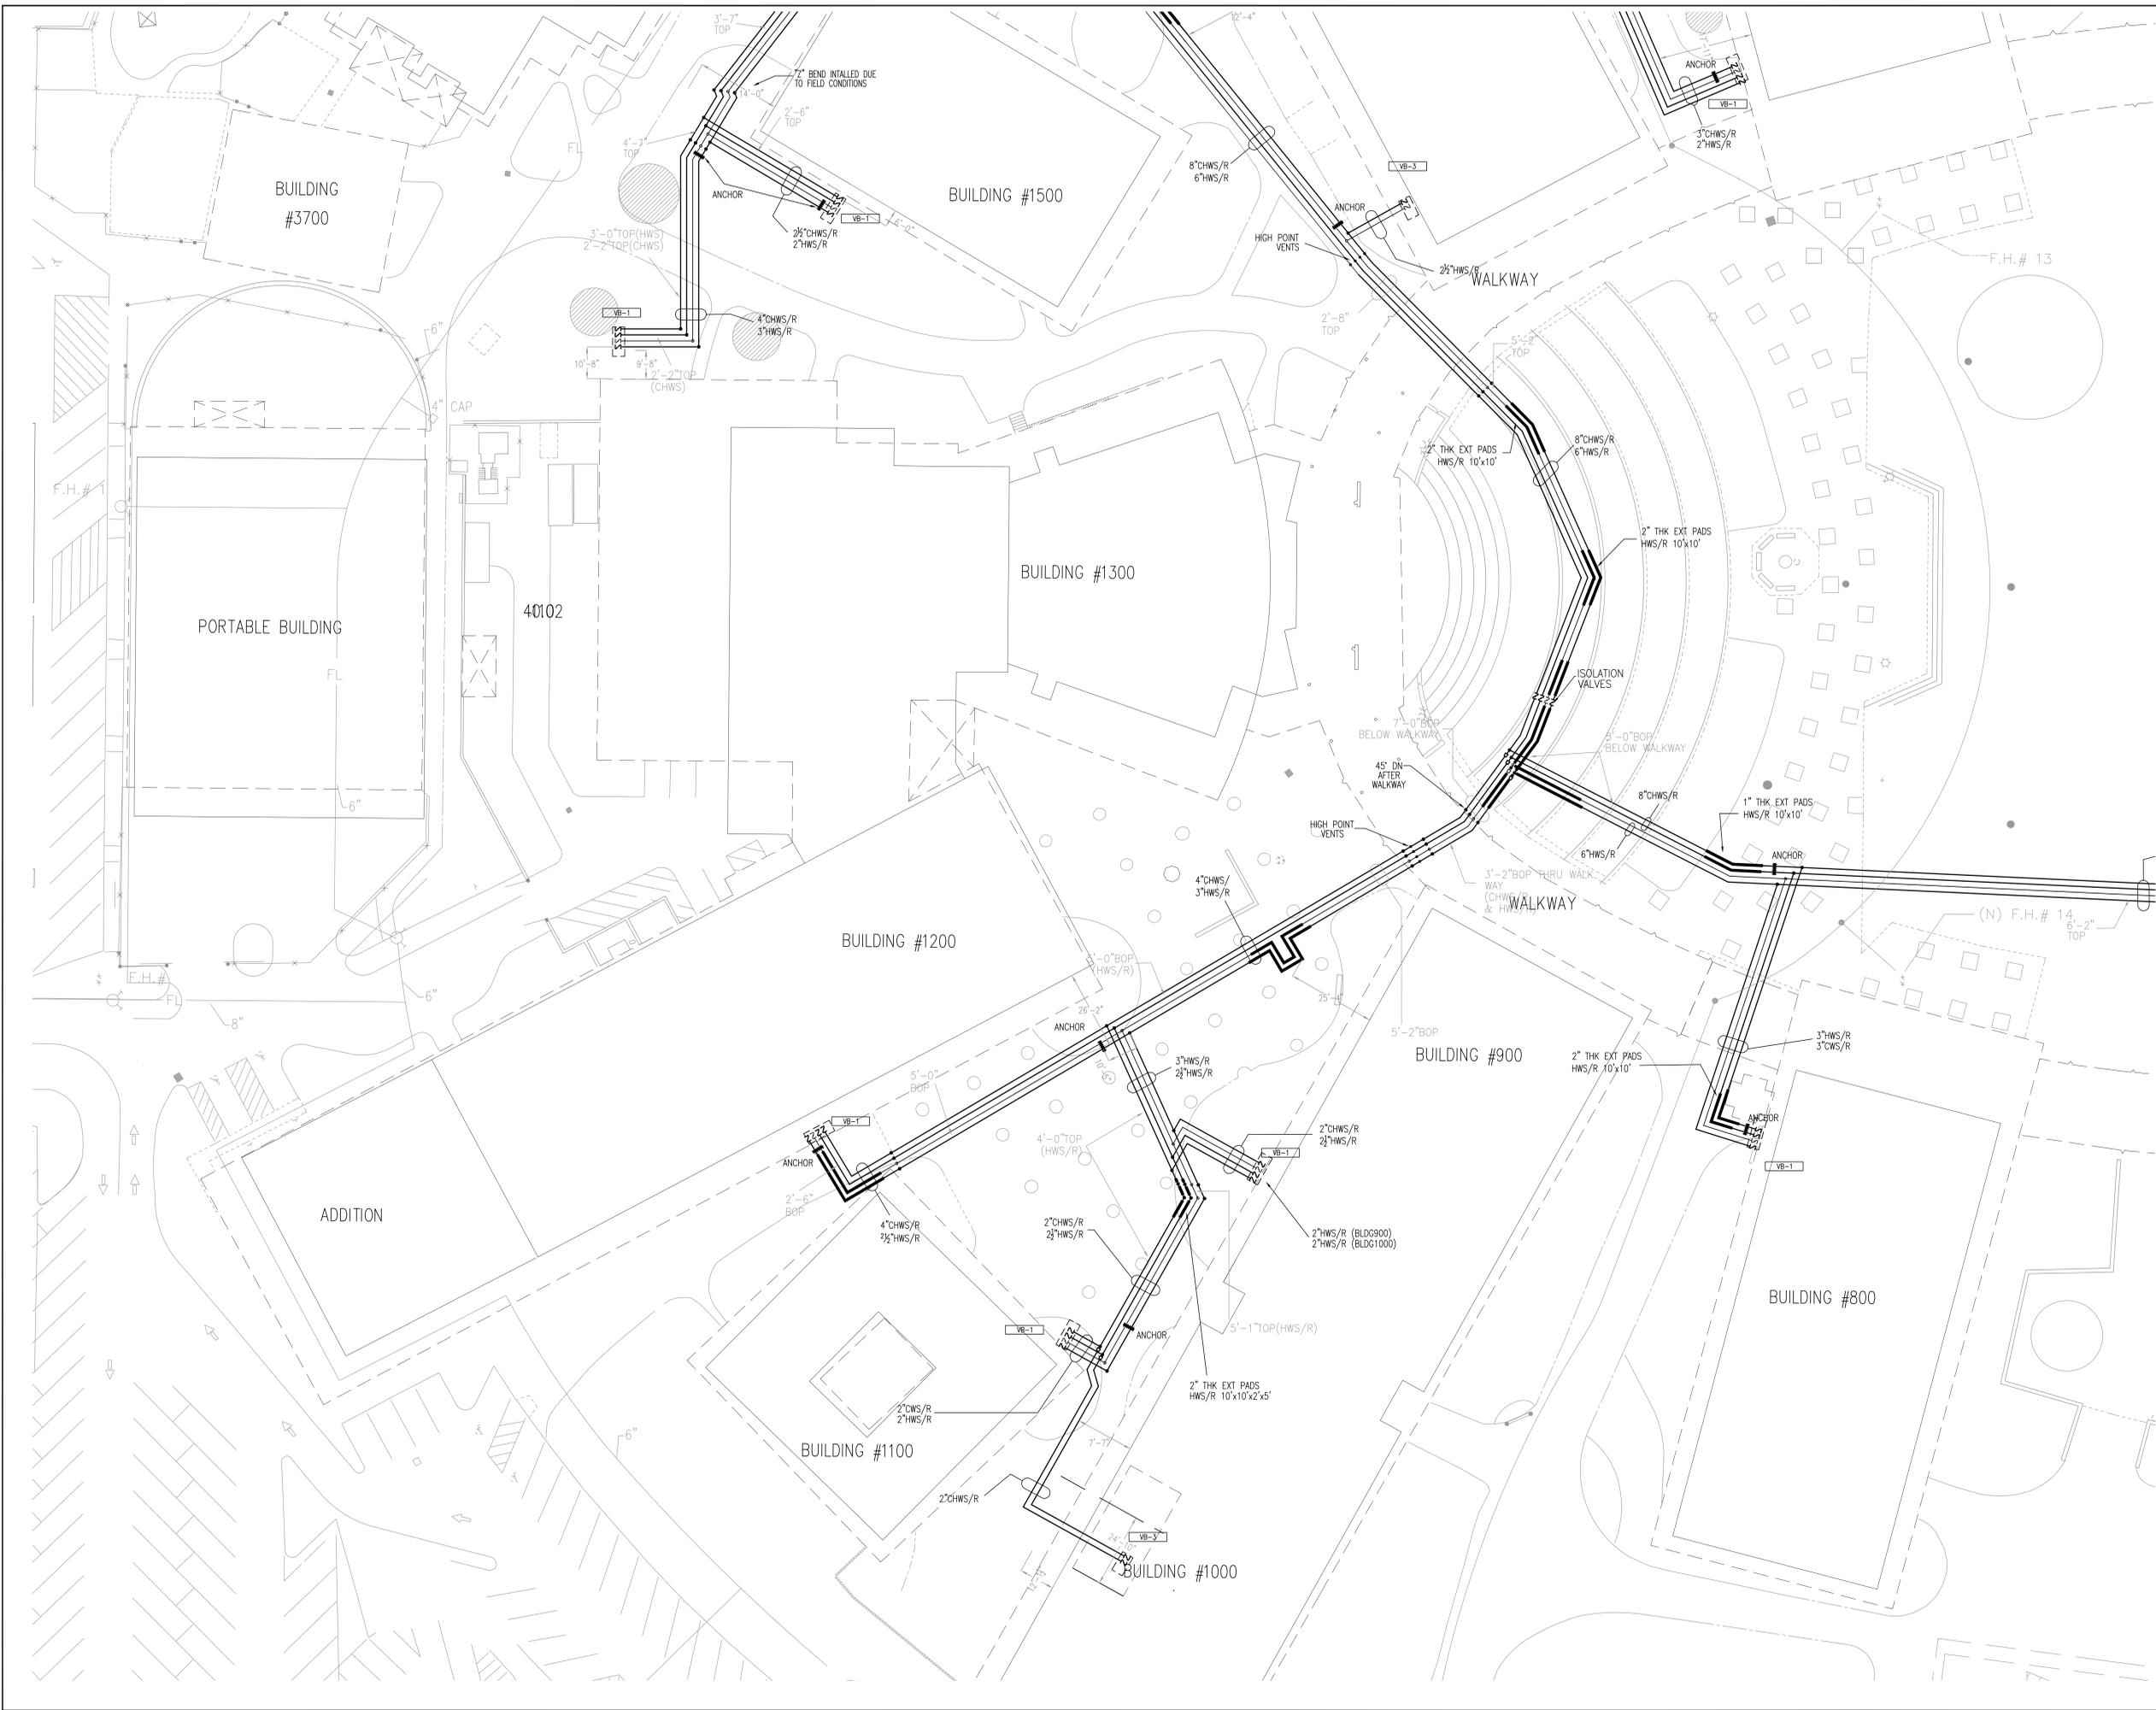

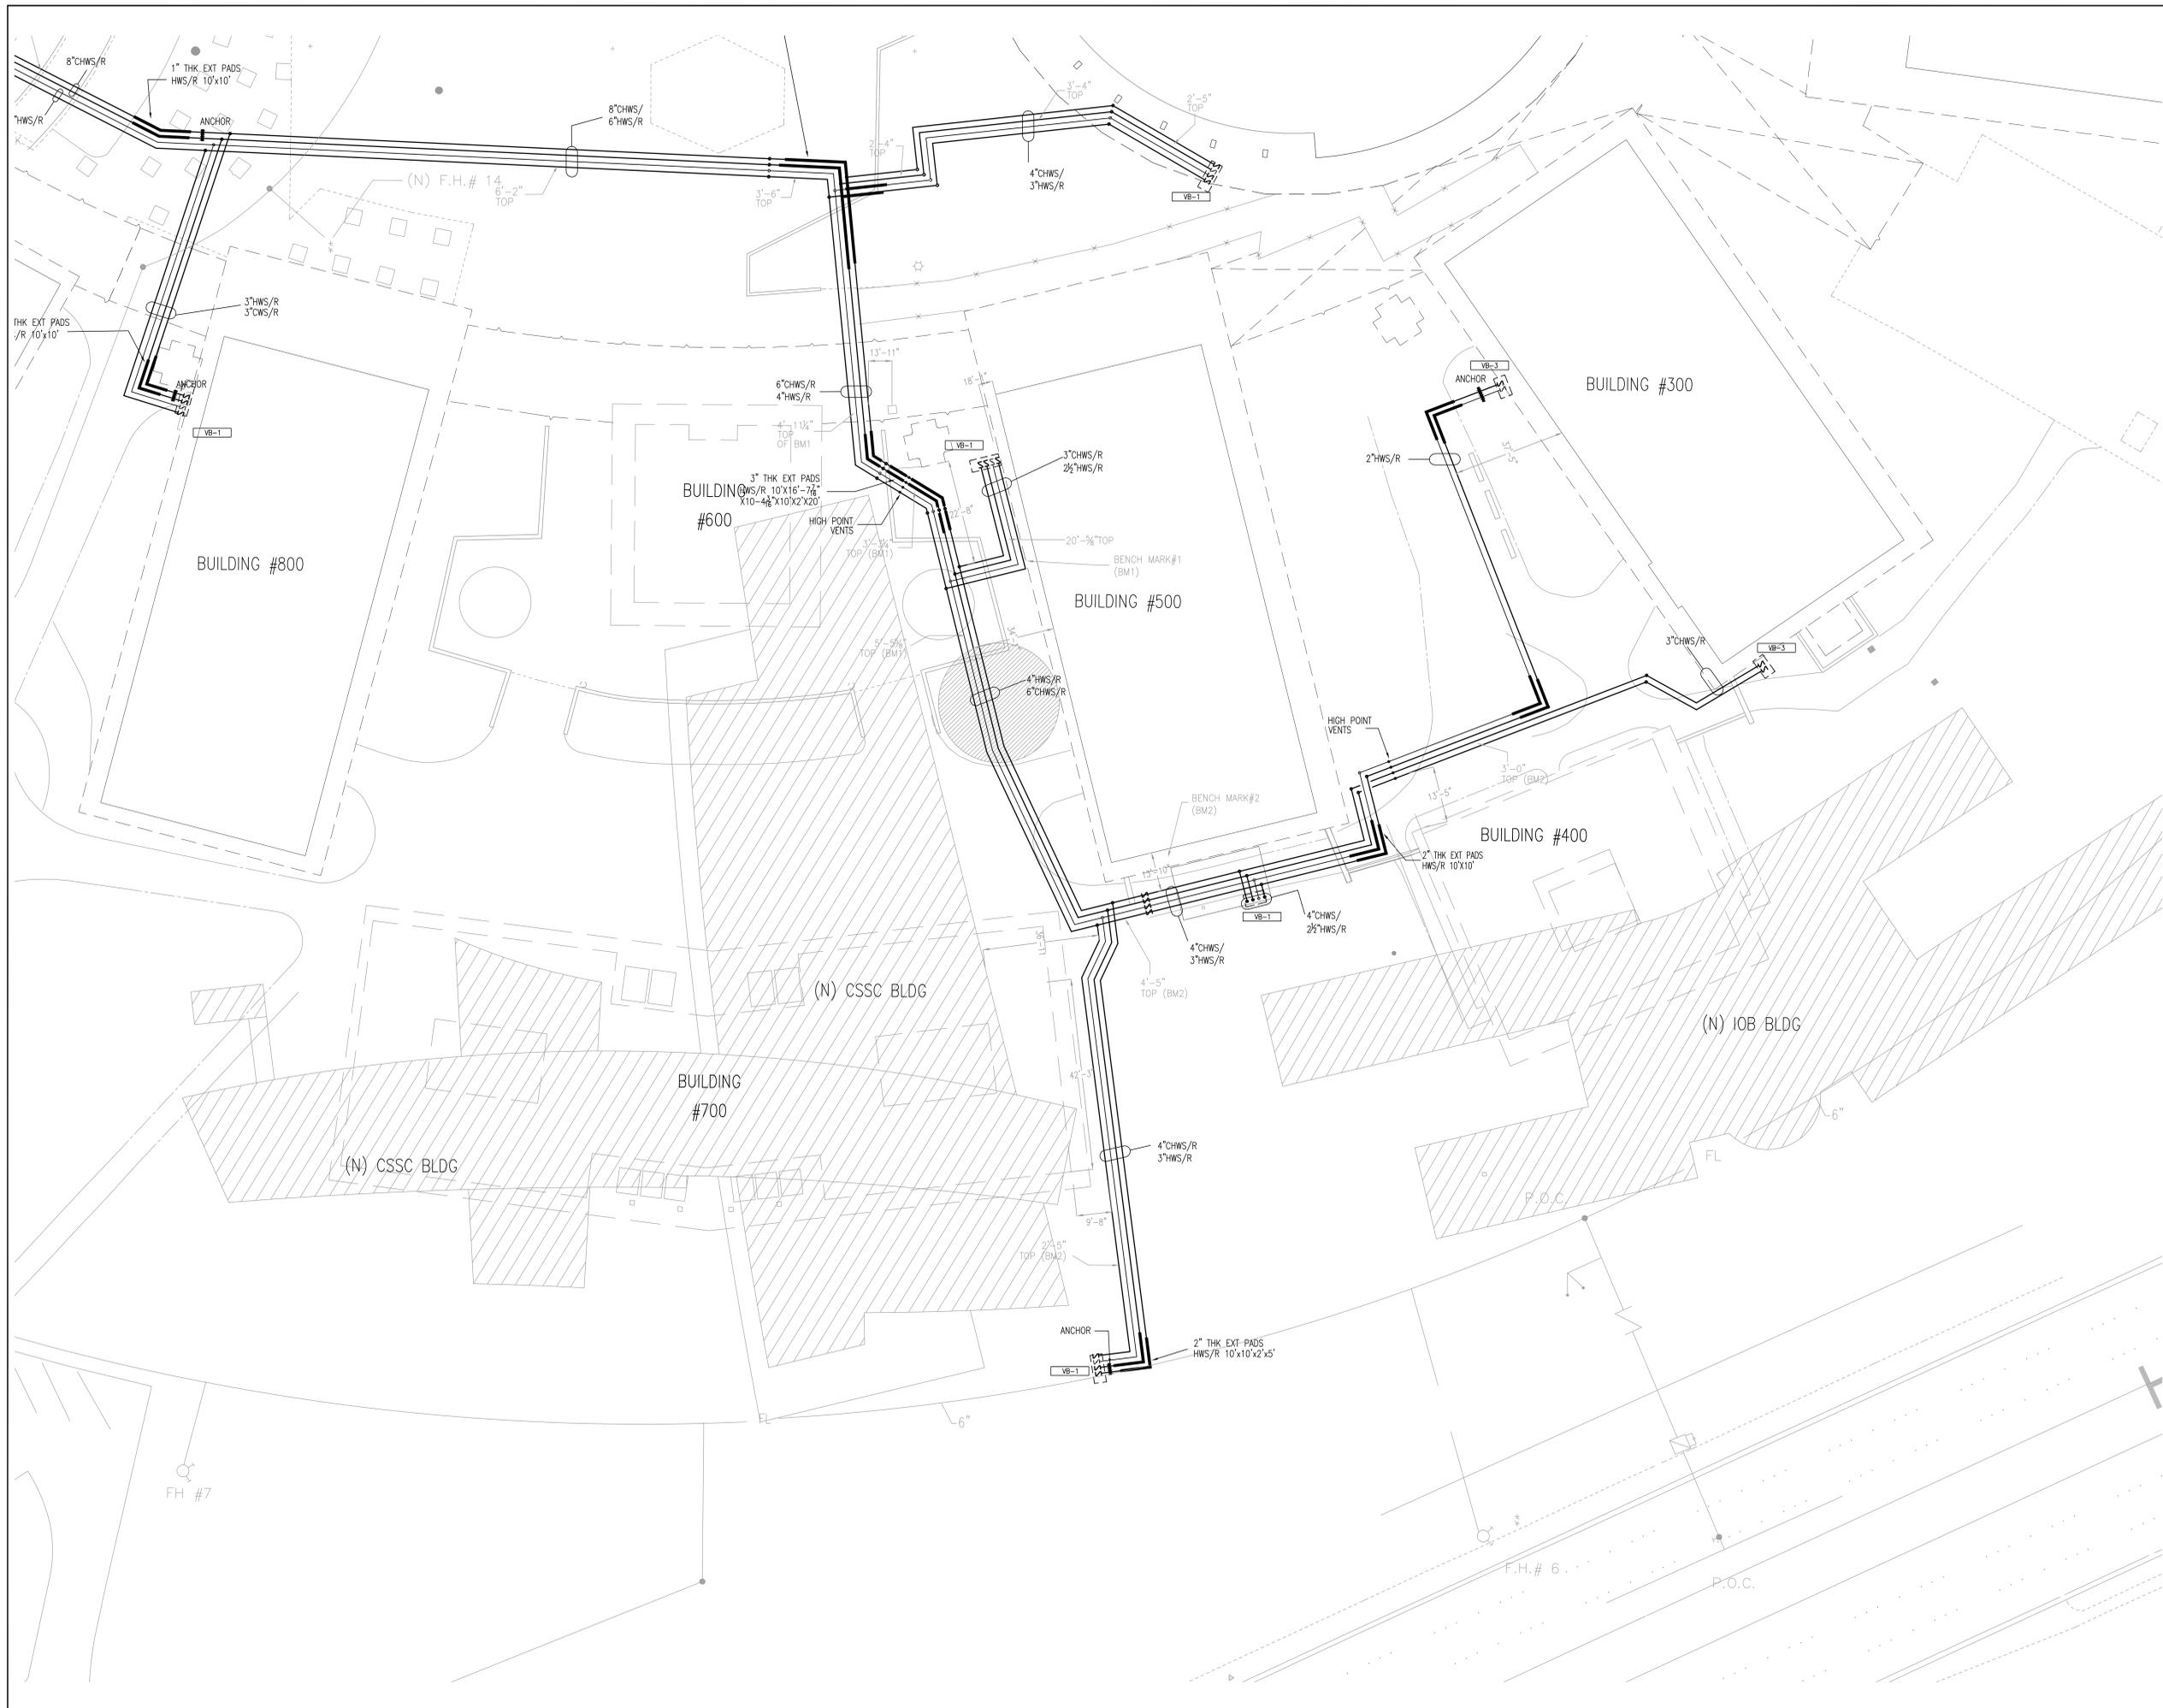

25555 HESPERIAN BLVD,
HAYWARD, CALIFORNIA

THE INCORPORATED STATE OF CALIFORNIA REGISTERED PROFESSIONAL ENGINEERS STAMP SERVES AS THE SELF CERTIFICATION FOR THESE DOCUMENTS.

SOUTHLAND INDUSTRIES




775 Commercial Street
San Jose, CA 95112
Tel: 408-970-3777
Fax: 408-970-3776

ALL DRAWINGS PREPARED BY SOUTHLAND INDUSTRIES ARE THE EXCLUSIVE PROPERTY OF SOUTHLAND INDUSTRIES AND, UNLESS OTHERWISE AGREED IN WRITING, SOUTHLAND INDUSTRIES SHALL BE DEEMED THE AUTHOR OF THEM AND SHALL RETAIN ALL COMMON LAW, STATUTORY AND OTHER RESERVED RIGHTS. IN ADDITION TO THE COPYRIGHT, ANY USE THEREOF WITHOUT THE EXPRESS WRITTEN CONSENT OF SOUTHLAND INDUSTRIES IS PROHIBITED



NO.	DESCRIPTION	DATE
-	50% CONSTRUCTION DOCUMENTS	06/31/07
-	90% CONSTRUCTION DOCUMENTS	09/21/07
-	ISSUED FOR CONSTRUCTION	11/05/07
-	AS-BUILT	03/06/09

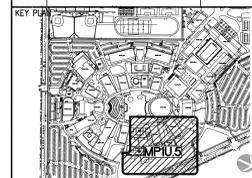

PROJECT TITLE
CHABOT COMMUNITY COLLEGE
CENTRAL PLANT PROJECT

SHEET TITLE
PARTIAL HYDRONIC PIPING PLAN

DRAWN BY PROJECT NO. 5617065	CHECKED BY UNIT SHEET NO.
SCALE: 1"=20'	MP1U.5
DATE 04-16-2007	




25555 HESPERIAN BLVD,
HAYWARD, CALIFORNIA

THE INCORPORATED STATE OF CALIFORNIA REGISTERED PROFESSIONAL ENGINEERS STAMP SERVES AS THE SELF CERTIFICATION FOR THESE DOCUMENTS.



ALL DRAWINGS PREPARED BY SOUTHLAND INDUSTRIES ARE THE EXCLUSIVE PROPERTY OF SOUTHLAND INDUSTRIES AND, UNLESS OTHERWISE AGREED IN WRITING, SOUTHLAND INDUSTRIES SHALL BE DEEMED THE AUTHOR OF THEM AND SHALL RETAIN ALL COMMON LAW, STATUTORY AND OTHER RESERVED RIGHTS, IN ADDITION TO THE COPYRIGHT. ANY USE THEREOF WITHOUT THE EXPRESS WRITTEN CONSENT OF SOUTHLAND INDUSTRIES IS PROHIBITED


REVISIONS		
NO.	DESCRIPTION	DATE
0	DSA PERMIT SET	02/21/08
1	DSA BACK CHECK	06/26/08
2	FIRE DEPT PERMIT SET	09/03/08
3	AS-BUILT	02/18/09

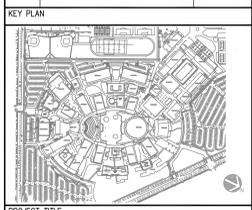

PROJECT TITLE
**CHABOT COMMUNITY COLLEGE
CENTRAL PLANT**
25555 HESPERIAN BLVD,
HAYWARD, CALIFORNIA

SHEET TITLE
BUILDING 2800 ENLARGED
PARTIAL MECHANICAL PIPING
FLOOR PLAN

DRAWN BY C_Garcia	CHECKED BY
PROJECT NO. 5617065	UNIT
SCALE: 1/2" = 1'-0"	SHEET NO. MP4.1
DATE 06-26-2008	

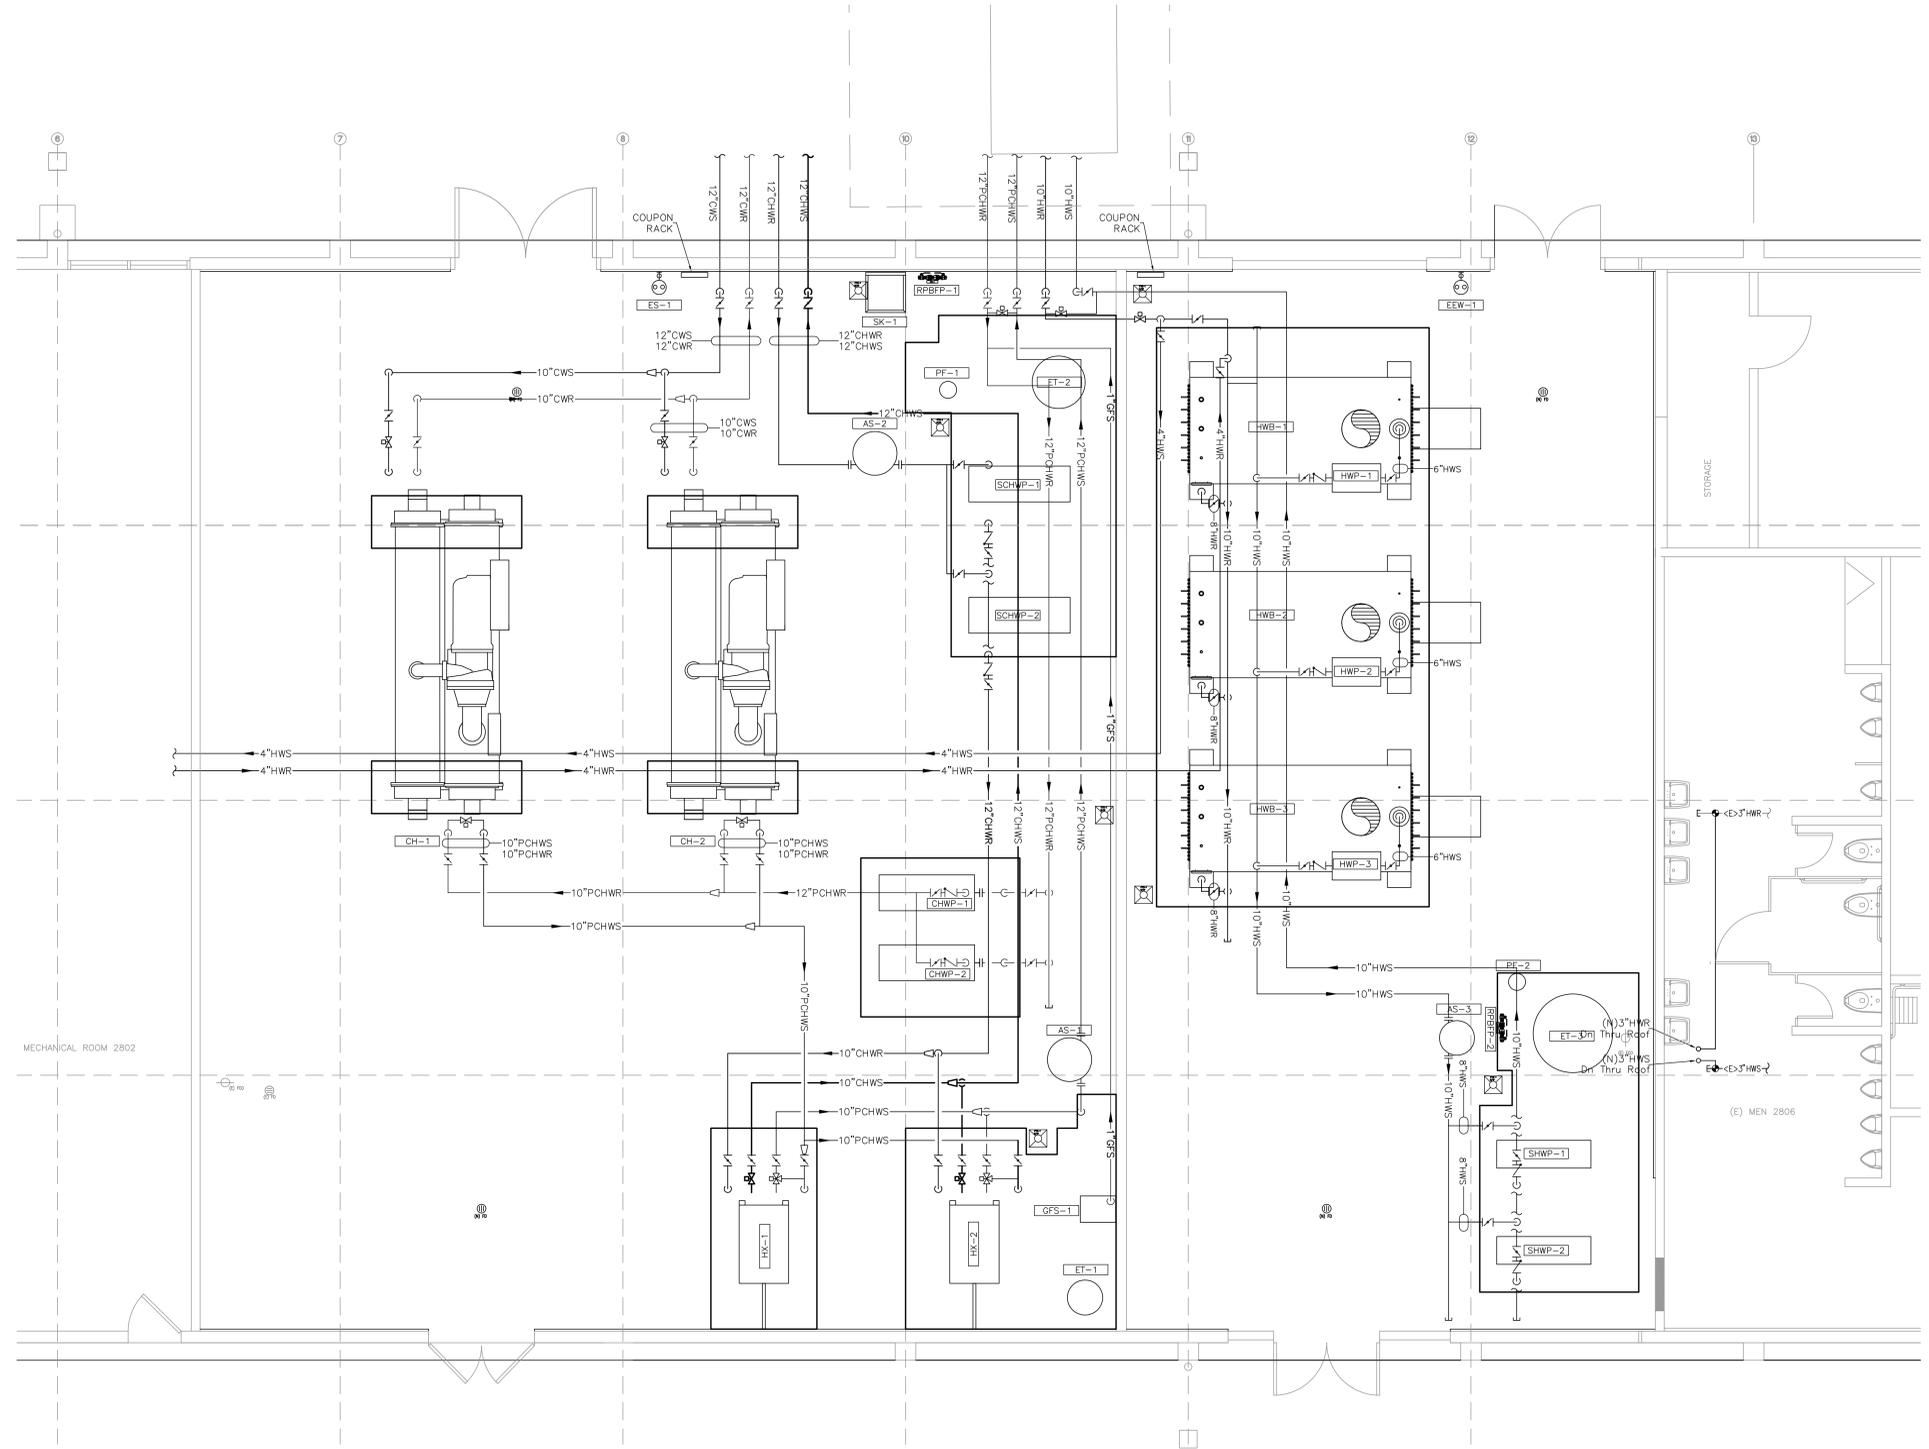

BUILDING 2800 – CHILLER/BOILER CENTRAL PLANT – MECHANICAL PIPING




25555 HESPERIAN BLVD,
HAYWARD, CALIFORNIA

THE INCORPORATED STATE OF CALIFORNIA REGISTERED PROFESSIONAL ENGINEERS STAMP SERVES AS THE SELF CERTIFICATION FOR THESE DOCUMENTS.



ALL DRAWINGS PREPARED BY SOUTHLAND INDUSTRIES ARE THE EXCLUSIVE PROPERTY OF SOUTHLAND INDUSTRIES AND, UNLESS OTHERWISE AGREED IN WRITING, SOUTHLAND INDUSTRIES SHALL BE DEEMED THE AUTHOR OF THEM AND SHALL RETAIN ALL COMMON LAW, STATUTORY AND OTHER RESERVED RIGHTS. IN ADDITION TO THE COPYRIGHT, ANY USE THEREOF WITHOUT THE EXPRESS WRITTEN CONSENT OF SOUTHLAND INDUSTRIES IS PROHIBITED.


NO.	DESCRIPTION	DATE
0	DSA PERMIT SET	02/21/08
1	DSA BACK CHECK	06/26/08
2	FIRE DEPT PERMIT SET	09/03/08
3	AS-BUILT	02/18/09

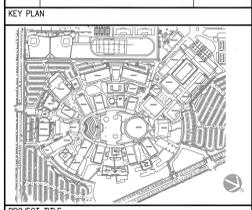

PROJECT TITLE
**CHABOT COMMUNITY COLLEGE
CENTRAL PLANT**
25555 HESPERIAN BLVD,
HAYWARD, CALIFORNIA

SHEET TITLE
ENLARGED PARTIAL
MECHANICAL YARD PLAN

DRAWN BY C_Garcia	CHECKED BY
PROJECT NO. 5617065	UNIT
SCALE: 1/2" = 1'-0"	SHEET NO. MP4.3
DATE 06-26-2008	

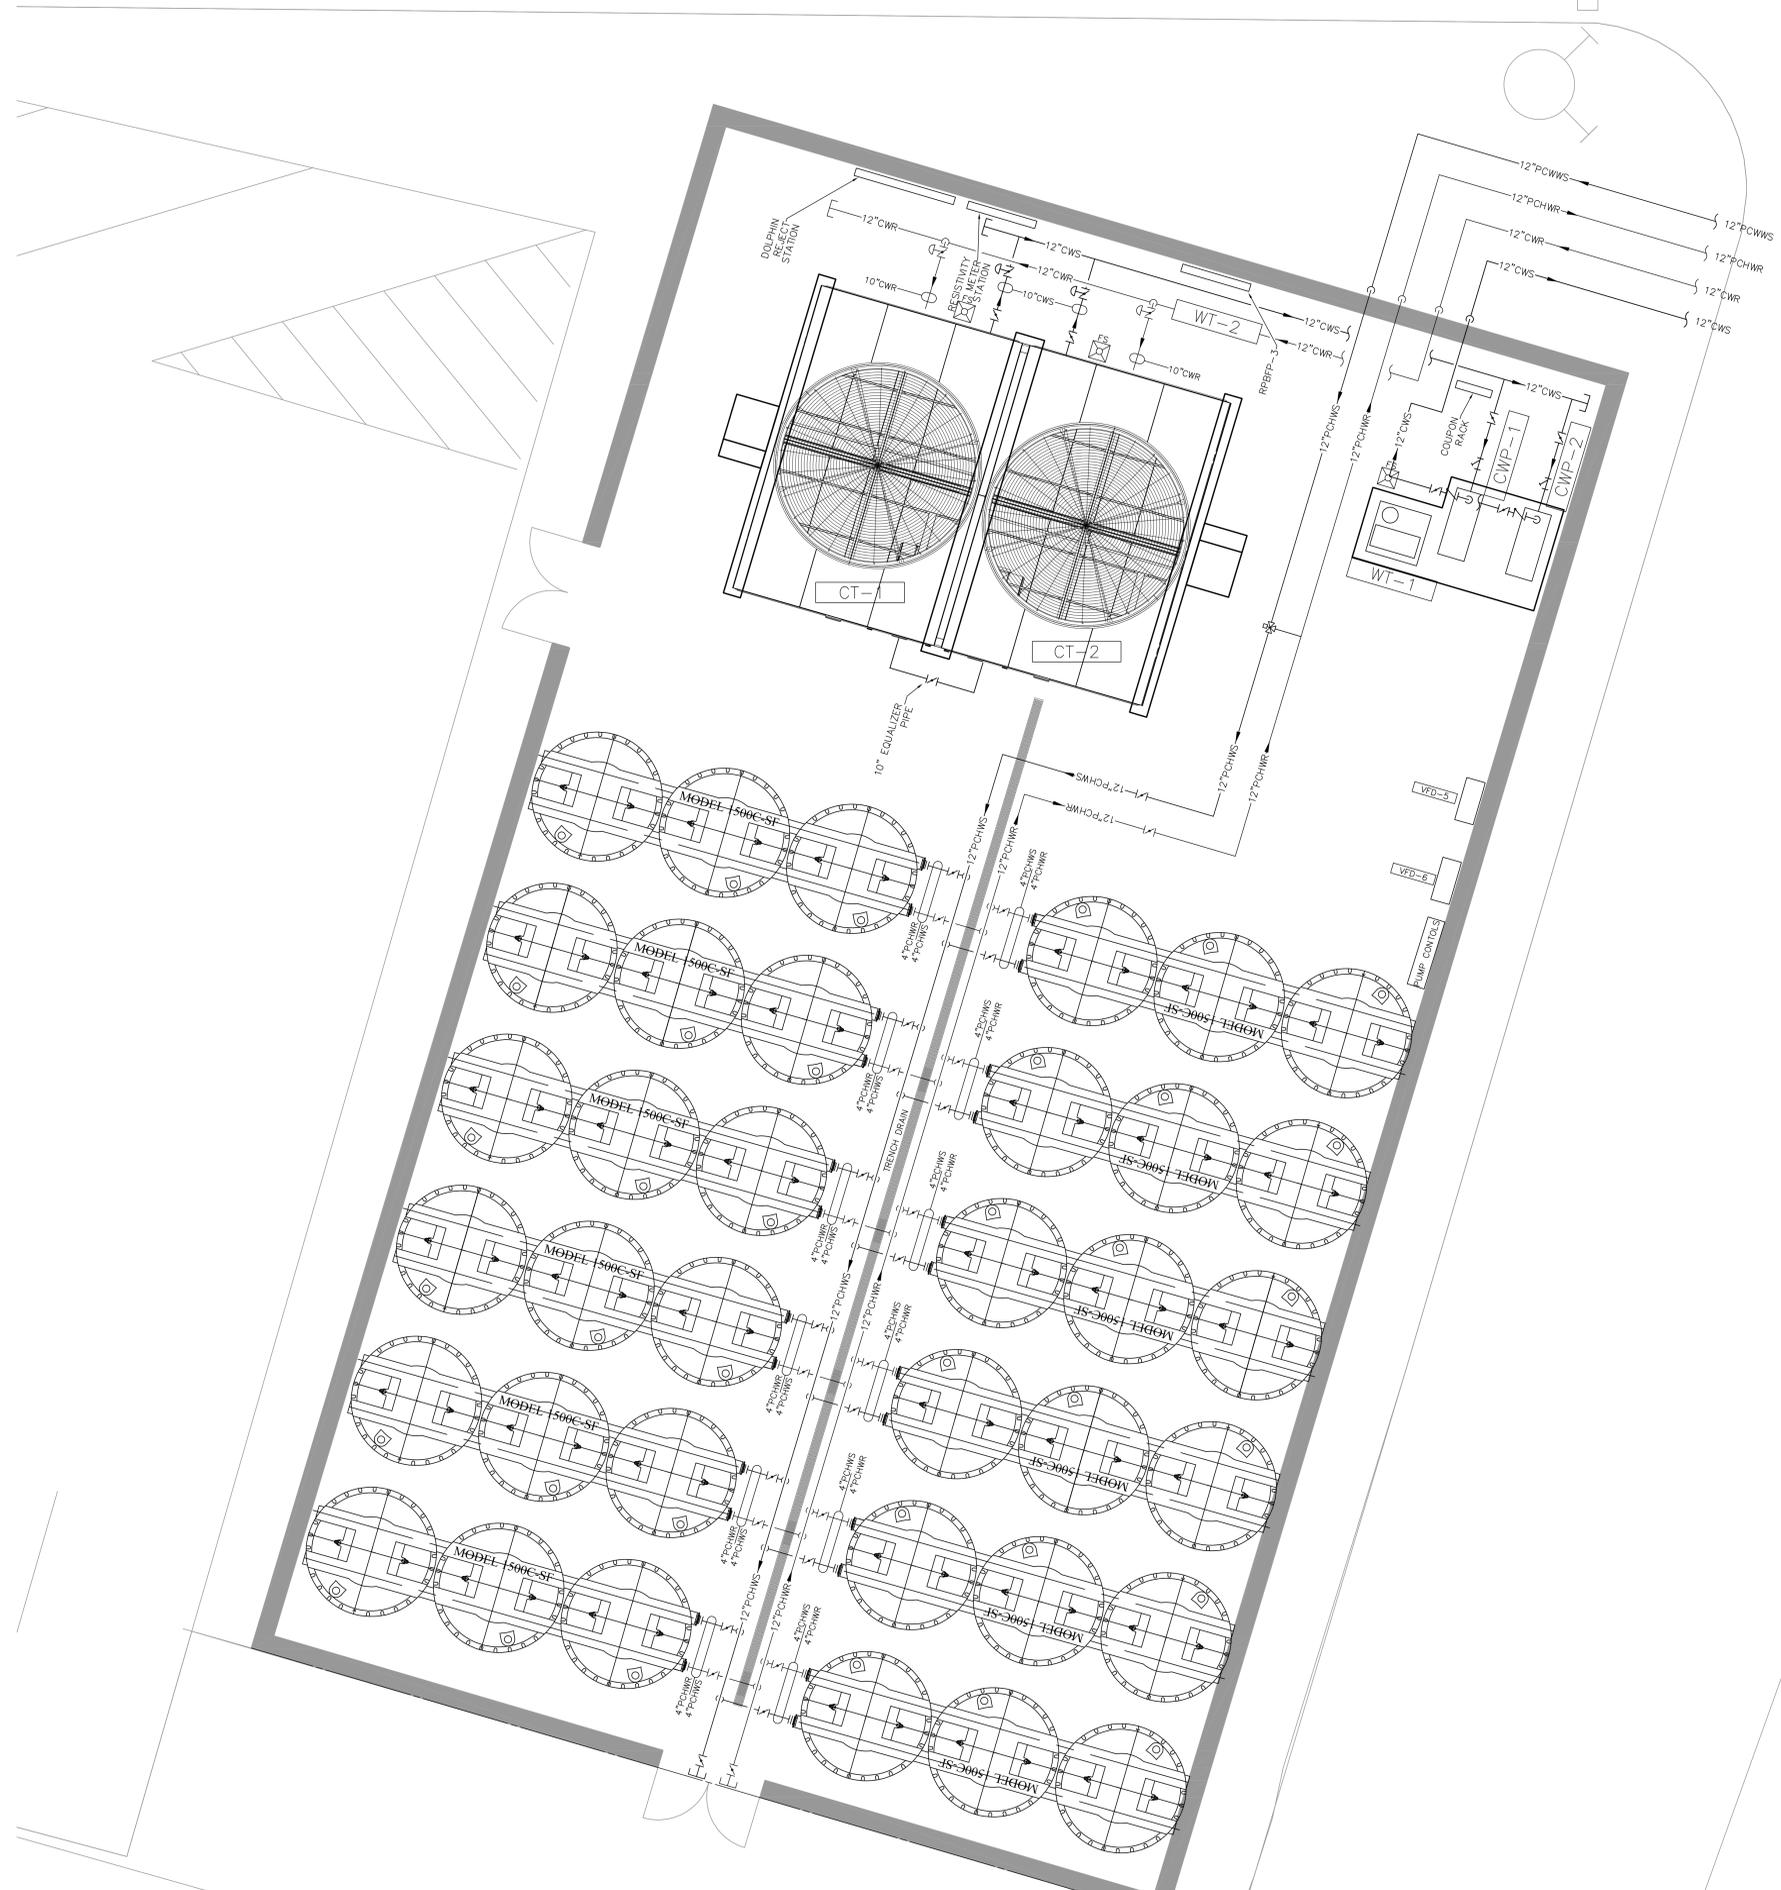




25555 HESPERIAN BLVD,
HAYWARD, CALIFORNIA

THE INCORPORATED STATE OF CALIFORNIA REGISTERED PROFESSIONAL ENGINEERS STAMP SERVES AS THE SELF CERTIFICATION FOR THESE DOCUMENTS.



ALL DRAWINGS PREPARED BY SOUTHLAND INDUSTRIES ARE THE EXCLUSIVE PROPERTY OF SOUTHLAND INDUSTRIES AND, UNLESS OTHERWISE AGREED IN WRITING, SOUTHLAND INDUSTRIES SHALL BE DEEMED THE AUTHOR OF THEM AND SHALL RETAIN ALL COMMON LAW, STATUTORY AND OTHER RESERVED RIGHTS, IN ADDITION TO THE COPYRIGHT, ANY USE THEREOF WITHOUT THE EXPRESS WRITTEN CONSENT OF SOUTHLAND INDUSTRIES IS PROHIBITED


NO.	DESCRIPTION	DATE
0	DSA PERMIT SET	02/21/08
1	DSA BACK CHECK	06/26/08
2	FIRE DEPT PERMIT SET	09/03/08
3	AS-BUILT	02/18/09

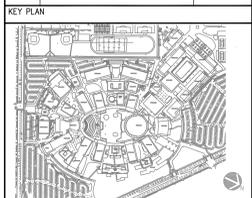

PROJECT TITLE
**CHABOT COMMUNITY COLLEGE
CENTRAL PLANT**
25555 HESPERIAN BLVD,
HAYWARD, CALIFORNIA

SHEET TITLE
BUILDING 2800
ENLARGED PARTIAL
PLUMBING - ROOF PLAN

DRAWN BY C_Garcia	CHECKED BY
PROJECT NO. 5617065	SHEET NO. PL4.4
SCALE:	
DATE 06-26-2008	

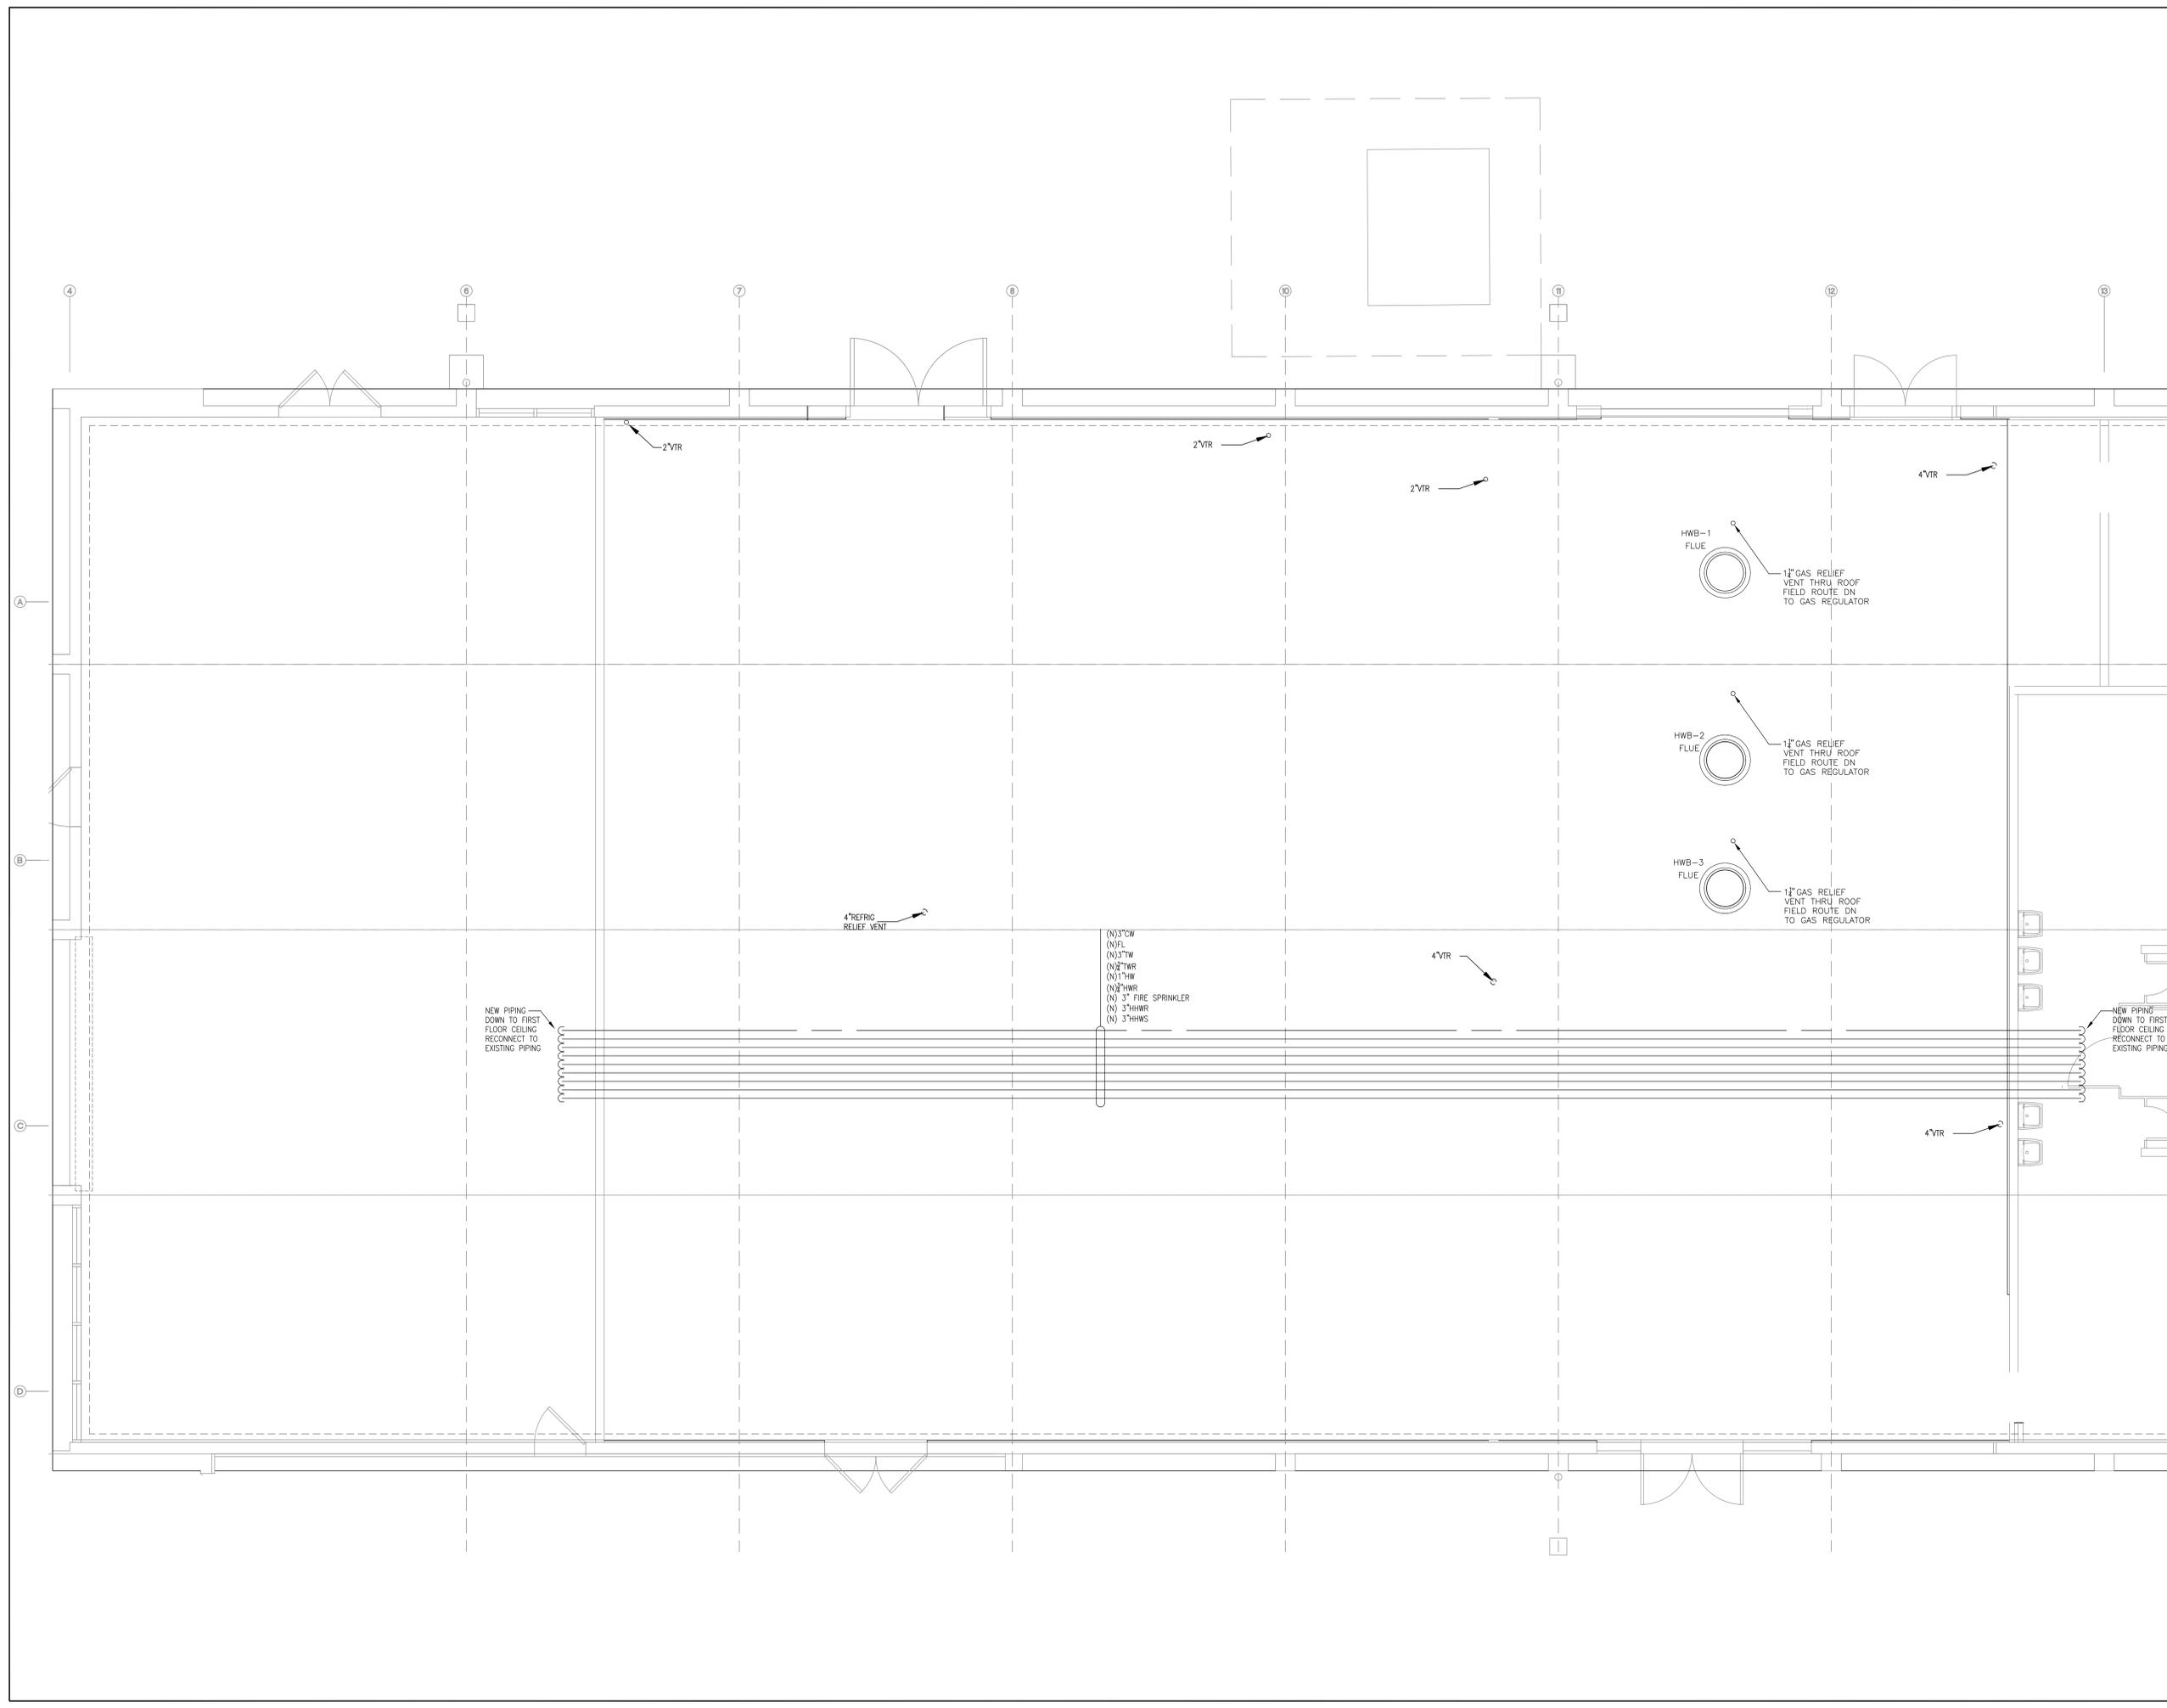



25555 HESPERIAN BLVD,
HAYWARD, CALIFORNIA

THE INCORPORATED STATE OF CALIFORNIA REGISTERED PROFESSIONAL ENGINEERS STAMP SERVES AS THE SELF CERTIFICATION FOR THESE DOCUMENTS.


SOUTHLAND INDUSTRIES



ALL DRAWINGS PREPARED BY SOUTHLAND INDUSTRIES ARE THE EXCLUSIVE PROPERTY OF SOUTHLAND INDUSTRIES AND, UNLESS OTHERWISE AGREED IN WRITING, SOUTHLAND INDUSTRIES SHALL BE DEEMED THE AUTHOR OF THEM AND SHALL RETAIN ALL COMMON LAW, STATUTORY AND OTHER RESERVED RIGHTS, IN ADDITION TO THE COPYRIGHT. ANY USE THEREOF WITHOUT THE EXPRESS WRITTEN CONSENT OF SOUTHLAND INDUSTRIES IS PROHIBITED




NO.	DESCRIPTION	DATE
0	DSA PERMIT SET	02/21/08
1	DSA BACK CHECK	06/26/08
2	AS BUILT	03/06/09

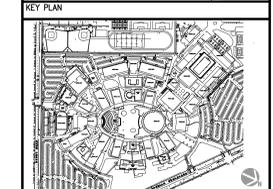

CHABOT COMMUNITY COLLEGE CENTRAL PLANT
25555 HESPERIAN BLVD,
HAYWARD, CALIFORNIA

SHEET TITLE
HOT WATER PIPING DIAGRAM

DRAWN BY PROJECT NO. 55117065 SCALE: DATE 06-26-2008	CHECKED BY UNIT SHEET NO. MP5.1
---	---

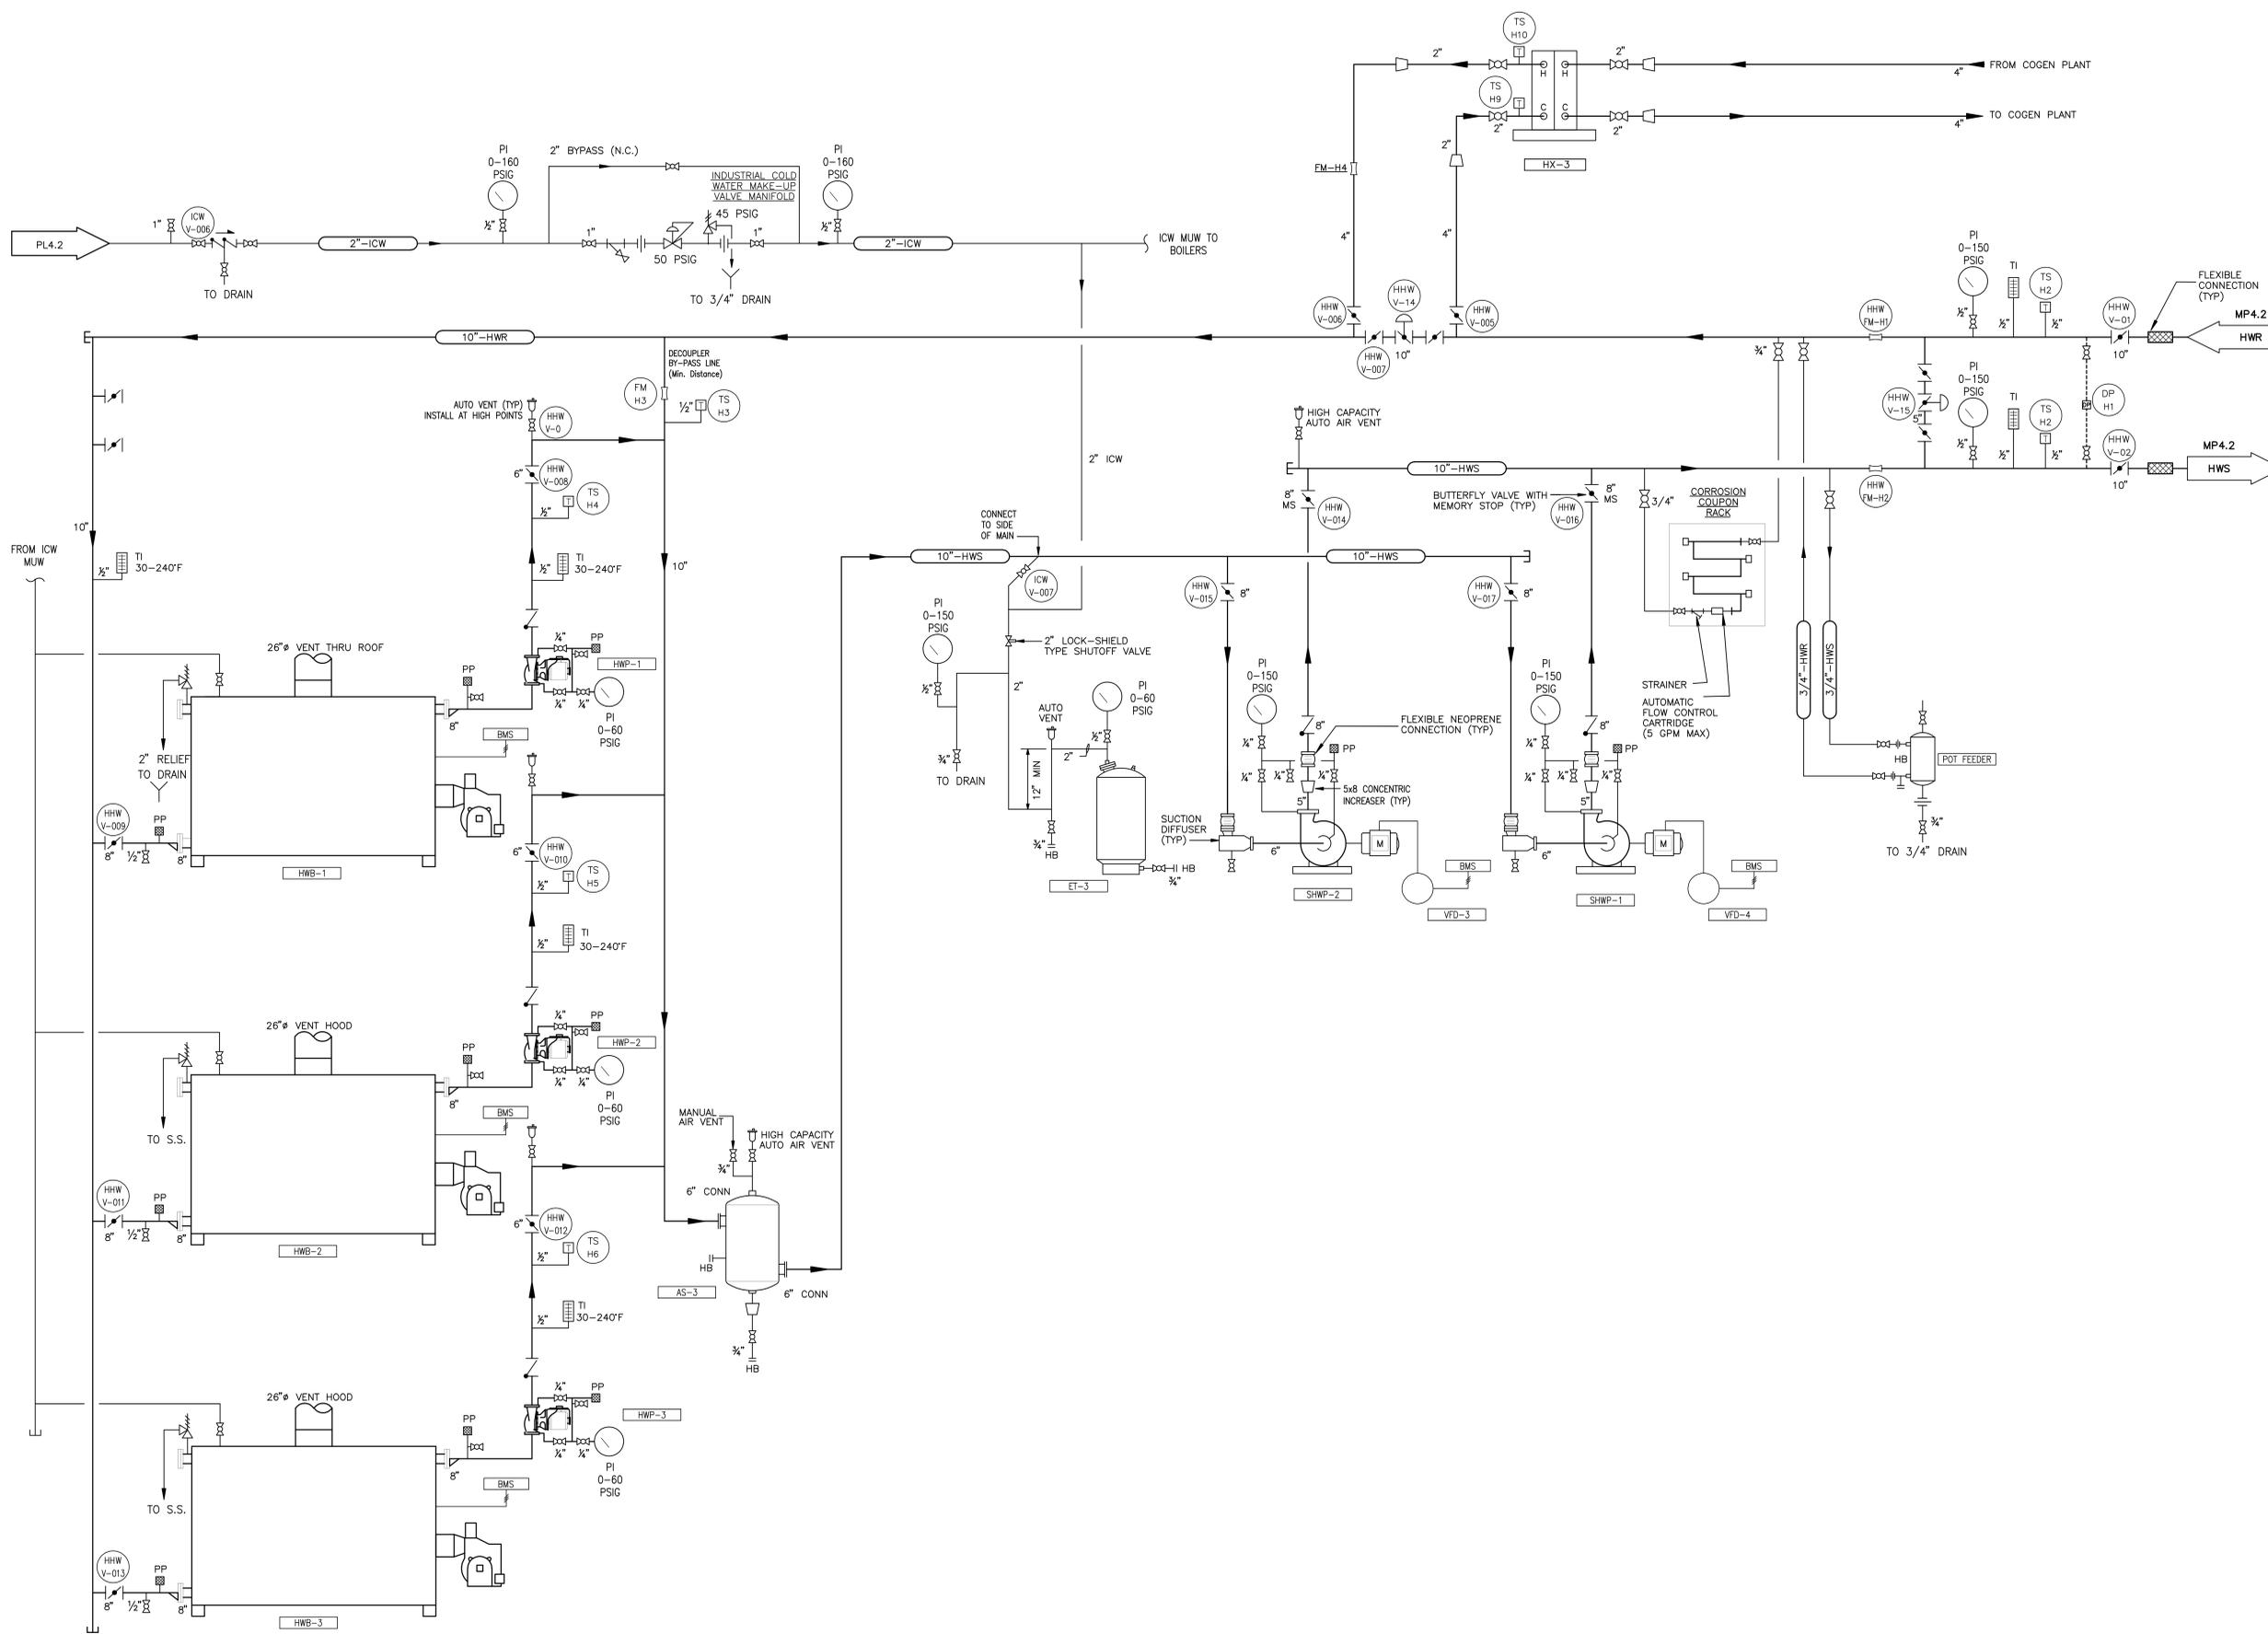



25555 HESPERIAN BLVD.
HAYWARD, CALIFORNIA

THE INCORPORATED STATE OF CALIFORNIA REGISTERED PROFESSIONAL ENGINEERS STAMP SERVES AS THE SELF CERTIFICATION FOR THESE DOCUMENTS.


SOUTHLAND INDUSTRIES



ALL DRAWINGS PREPARED BY SOUTHLAND INDUSTRIES ARE THE EXCLUSIVE PROPERTY OF SOUTHLAND INDUSTRIES AND, UNLESS OTHERWISE AGREED IN WRITING, SOUTHLAND INDUSTRIES SHALL BE DEEMED THE AUTHOR OF THEM AND SHALL RETAIN ALL COMMON LAW, STATUTORY AND OTHER RESERVED RIGHTS, IN ADDITION TO THE COPYRIGHT. ANY USE THEREOF WITHOUT THE EXPRESS WRITTEN CONSENT OF SOUTHLAND INDUSTRIES IS PROHIBITED




NO.	DESCRIPTION	DATE
0	DSA PERMIT SET	02/21/08
1	DSA BACK CHECK	06/26/08
2	AS BUILT	03/06/09

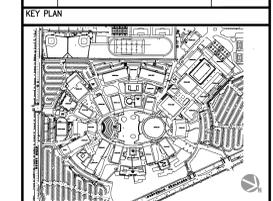

CHABOT COMMUNITY COLLEGE CENTRAL PLANT
25555 HESPERIAN BLVD,
HAYWARD, CALIFORNIA

CONDENSER WATER PIPING DIAGRAM

DRAWN BY SG17065	CHECKED BY MP5.2
PROJECT NO. 5517065	UNIT
SCALE	SHEET NO.
DATE 06-26-2008	

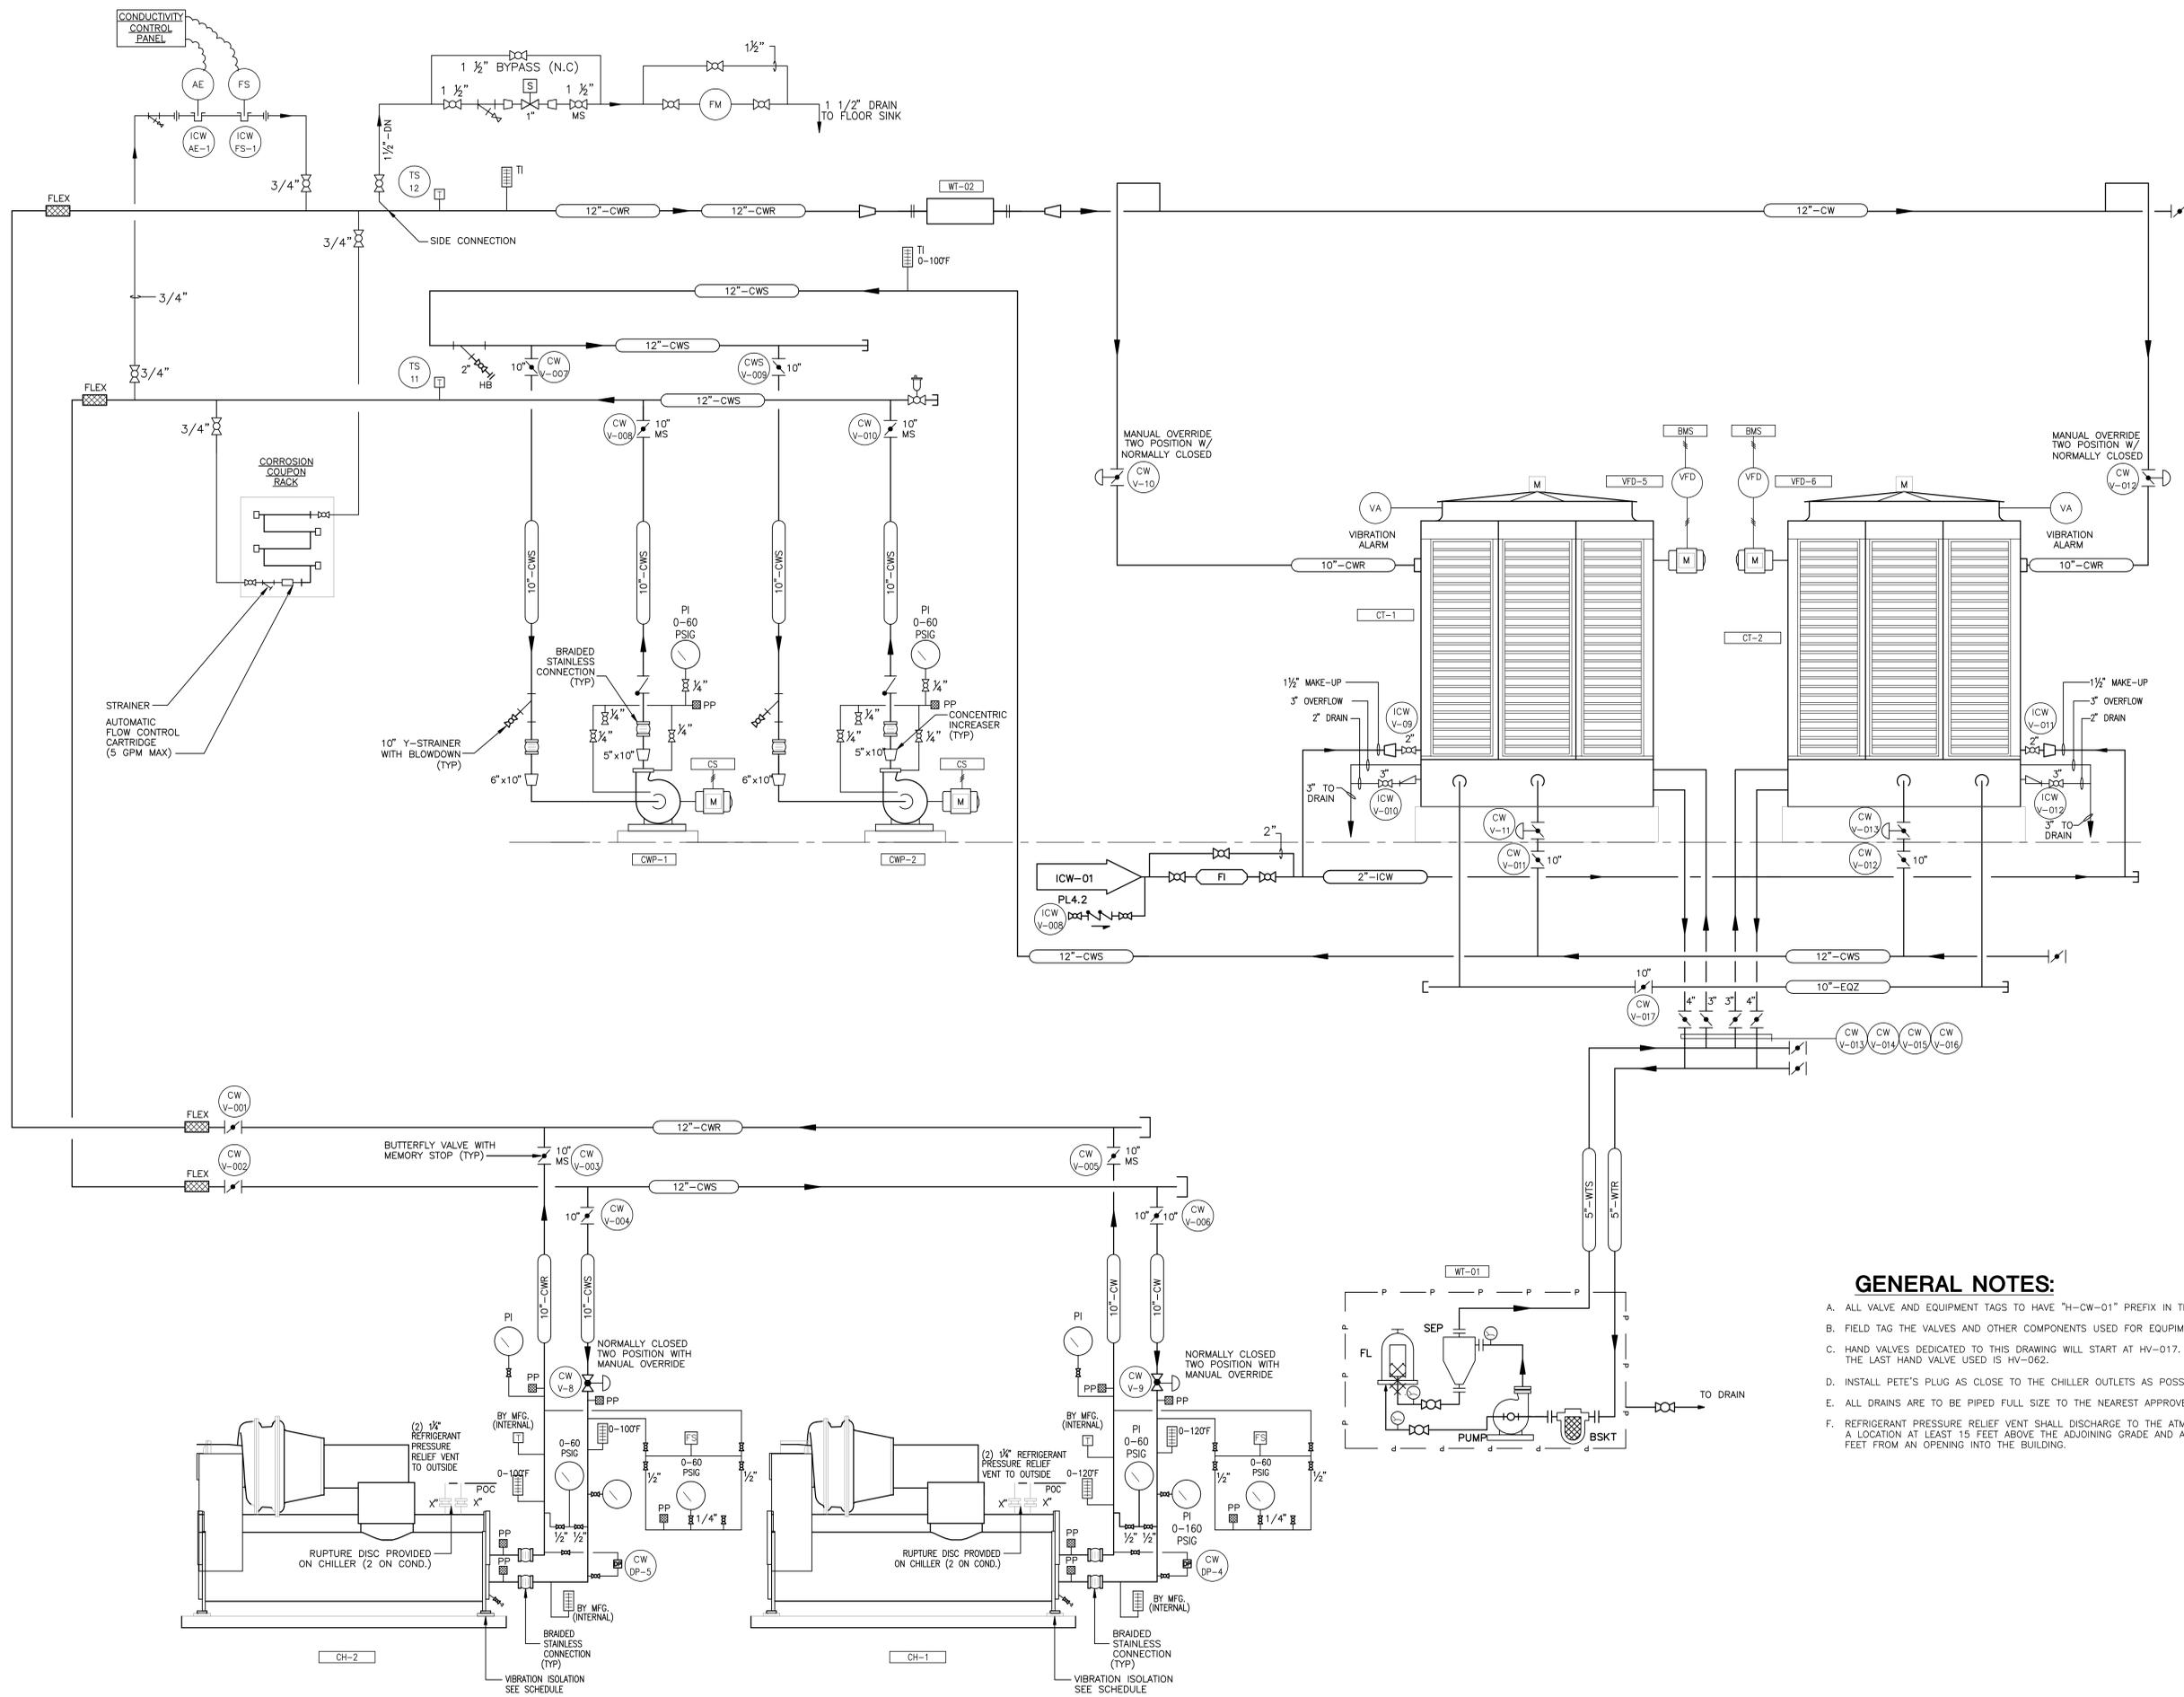

GENERAL NOTES:


- A. ALL VALVE AND EQUIPMENT TAGS TO HAVE "H-CW-01" PREFIX IN THE FIELD.
- B. FIELD TAG THE VALVES AND OTHER COMPONENTS USED FOR EQUIPMENT HOOKUP.
- C. HAND VALVES DEDICATED TO THIS DRAWING WILL START AT HV-017. THE LAST HAND VALVE USED IS HV-062.
- D. INSTALL PETE'S PLUG AS CLOSE TO THE CHILLER OUTLETS AS POSSIBLE.
- E. ALL DRAINS ARE TO BE PIPED FULL SIZE TO THE NEAREST APPROVED RECEPTOR.
- F. REFRIGERANT PRESSURE RELIEF VENT SHALL DISCHARGE TO THE ATMOSPHERE AT A LOCATION AT LEAST 15 FEET ABOVE THE ADJOINING GRADE AND AT LEAST 20 FEET FROM AN OPENING INTO THE BUILDING.

SHEET KEYNOTES

- ① NOT USED
- ② RELIEF VALVE, SET AT PRESSURE AS REQUIRED BY ICE TANK HEAT EXCHANGER MANUFACTURER.
- ③ NORMALLY CLOSED, START UP BY-PASS FLUSH VALVE
- ④ TAP OFF SIDE OF PIPE. DO NOT ALLOW AIR OR DIRT IN THIS LINE.
- ⑤ PROVIDE 6 PIPE DIAMETERS OF STRAIGHT PIPE UP STREAM OR PUMP SUCTION.
- ⑥ PROVIDE A MINIMUM OF 10X PIPE DIAM. STRAIGHT PIPE UPSTREAM & 5x PIPE DIAM. DOWNSTREAM OF ALL FLOW METERS UON.

GENERAL NOTES

1. PROVIDE REFRIGERANT RELIEF PIPING AND EXTEND TO EXTERIOR OF THE BUILDING TO A MINIMUM DISTANCE OF 20 FEET FROM ANY AIR INTAKE OPENING.
2. INSTALLATION OF COOLING TOWERS, CHILLERS AND PIPING CONNECTIONS TO THEM SHALL BE IN STRICT ACCORDANCE WITH MANUFACTURER'S RECOMMENDATIONS.
3. PROVIDE AUTOMATIC VENTING AT HIGH POINTS IN THE CHILLER WATER SYSTEM TO ELIMINATE ANY TRAPPED AIR. ROUTE DISCHARGE TO DRAIN.
4. DRAIN ALL LOW POINTS OF SYSTEMS AND RISERS TO NEAREST FLOOR DRAIN. ALL DRAINS ON PIPING 6" AND ABOVE SHALL BE 2" MIN.
5. PROVIDE ADDITIONAL MECHANICAL COUPLINGS OR FLANGED CONNECTIONS FOR CHILLERS AS REQUIRED TO REMOVE A MINIMUM AMOUNT OF PIPING FOR TUBE CLEANING AND REMOVAL. (TYPICAL FOR CONDENSER AND EVAPORATOR INLET AND OUTLET PIPING).
6. WATER FLOW MEASURING DEVICES SHALL BE INSTALLED PER MANUFACTURER'S RECOMMENDATIONS.
7. SUPPORT PIPING INDEPENDENT OF EQUIPMENT.
8. ALL DRAIN CONNECTIONS FROM MECHANICAL EQUIPMENT SHALL BE PIPED TO SPILL INDIRECTLY INTO NEAREST FLOOR DRAIN.
9. INSTALL THERMOMETERS AND PRESSURE GAGES AT EYE LEVEL.
10. PROVIDE ELBOW SUPPORT AT ALL PIPE CONNECTIONS TO EQUIPMENT.
11. COORDINATE INSTALLATION OF DIFFERENTIAL PRESSURE SENSORS WITH CONTROL CONTRACTOR.
12. ALL MOTORIZED VALVES SHALL BE PROVIDED WITH LIMIT END SWITCHES FOR REMOTE SENSING OF POSITION INDICATION (FULL OPEN, FULL CLOSED, OR 1/2 OPEN). PROVIDE ALL APPURTENANCES NECESSARY FOR REMOTE MONITORING.
13. ALL VALVES AND HYDRONIC SPECIALITIES WITHIN GLYCOL LOOP SHALL BE PROVIDED FOR SYSTEM OPERATING TEMPERATURES.

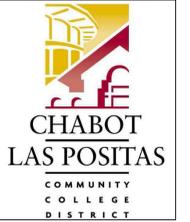

25555 HESPERIAN BLVD.
HAYWARD, CALIFORNIA

THE INCORPORATED STATE OF CALIFORNIA REGISTERED PROFESSIONAL ENGINEERS STAMP SERVES AS THE SELF CERTIFICATION FOR THESE DOCUMENTS.


SOUTHLAND INDUSTRIES



ALL DRAWINGS PREPARED BY SOUTHLAND INDUSTRIES ARE THE EXCLUSIVE PROPERTY OF SOUTHLAND INDUSTRIES AND, UNLESS OTHERWISE AGREED IN WRITING, SOUTHLAND INDUSTRIES SHALL BE DEEMED THE AUTHOR OF THEM AND SHALL RETAIN ALL COMMON LAW, STATUTORY AND OTHER RESERVED RIGHTS, IN ADDITION TO THE COPYRIGHT. ANY USE THEREOF WITHOUT THE EXPRESS WRITTEN CONSENT OF SOUTHLAND INDUSTRIES IS PROHIBITED



NO.	DESCRIPTION	DATE
0	ISA PERMIT SET	02/21/08
1	ISA BACK CHECK	06/26/08
2	AS BUILT	03/06/09

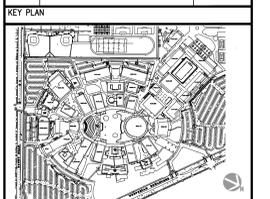


CHABOT COMMUNITY COLLEGE CENTRAL PLANT
25555 HESPERIAN BLVD.
HAYWARD, CALIFORNIA


SHEET TITLE
CHILLED WATER PIPING DIAGRAM-PRIMARY

DRAWN BY	CHECKED BY
PROJECT NO. 5617065	UNIT
SCALE:	SHEET NO. MP5.3
DATE 06-26-2008	


REFRIGERANT PRESSURE RELIEF DEVICES SHALL DISCHARGE TO THE ATMOSPHERE AT A LOCATION AT LEAST 15 FEET ABOVE THE ADJOINING GRADE LEVEL AND AT LEAST 20 FEET FROM AN OPENING INTO THE BUILDING.

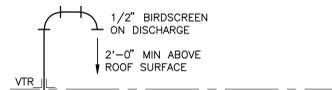

REFRIGERANT PRESSURE RELIEF VENT UP THRU ROOF

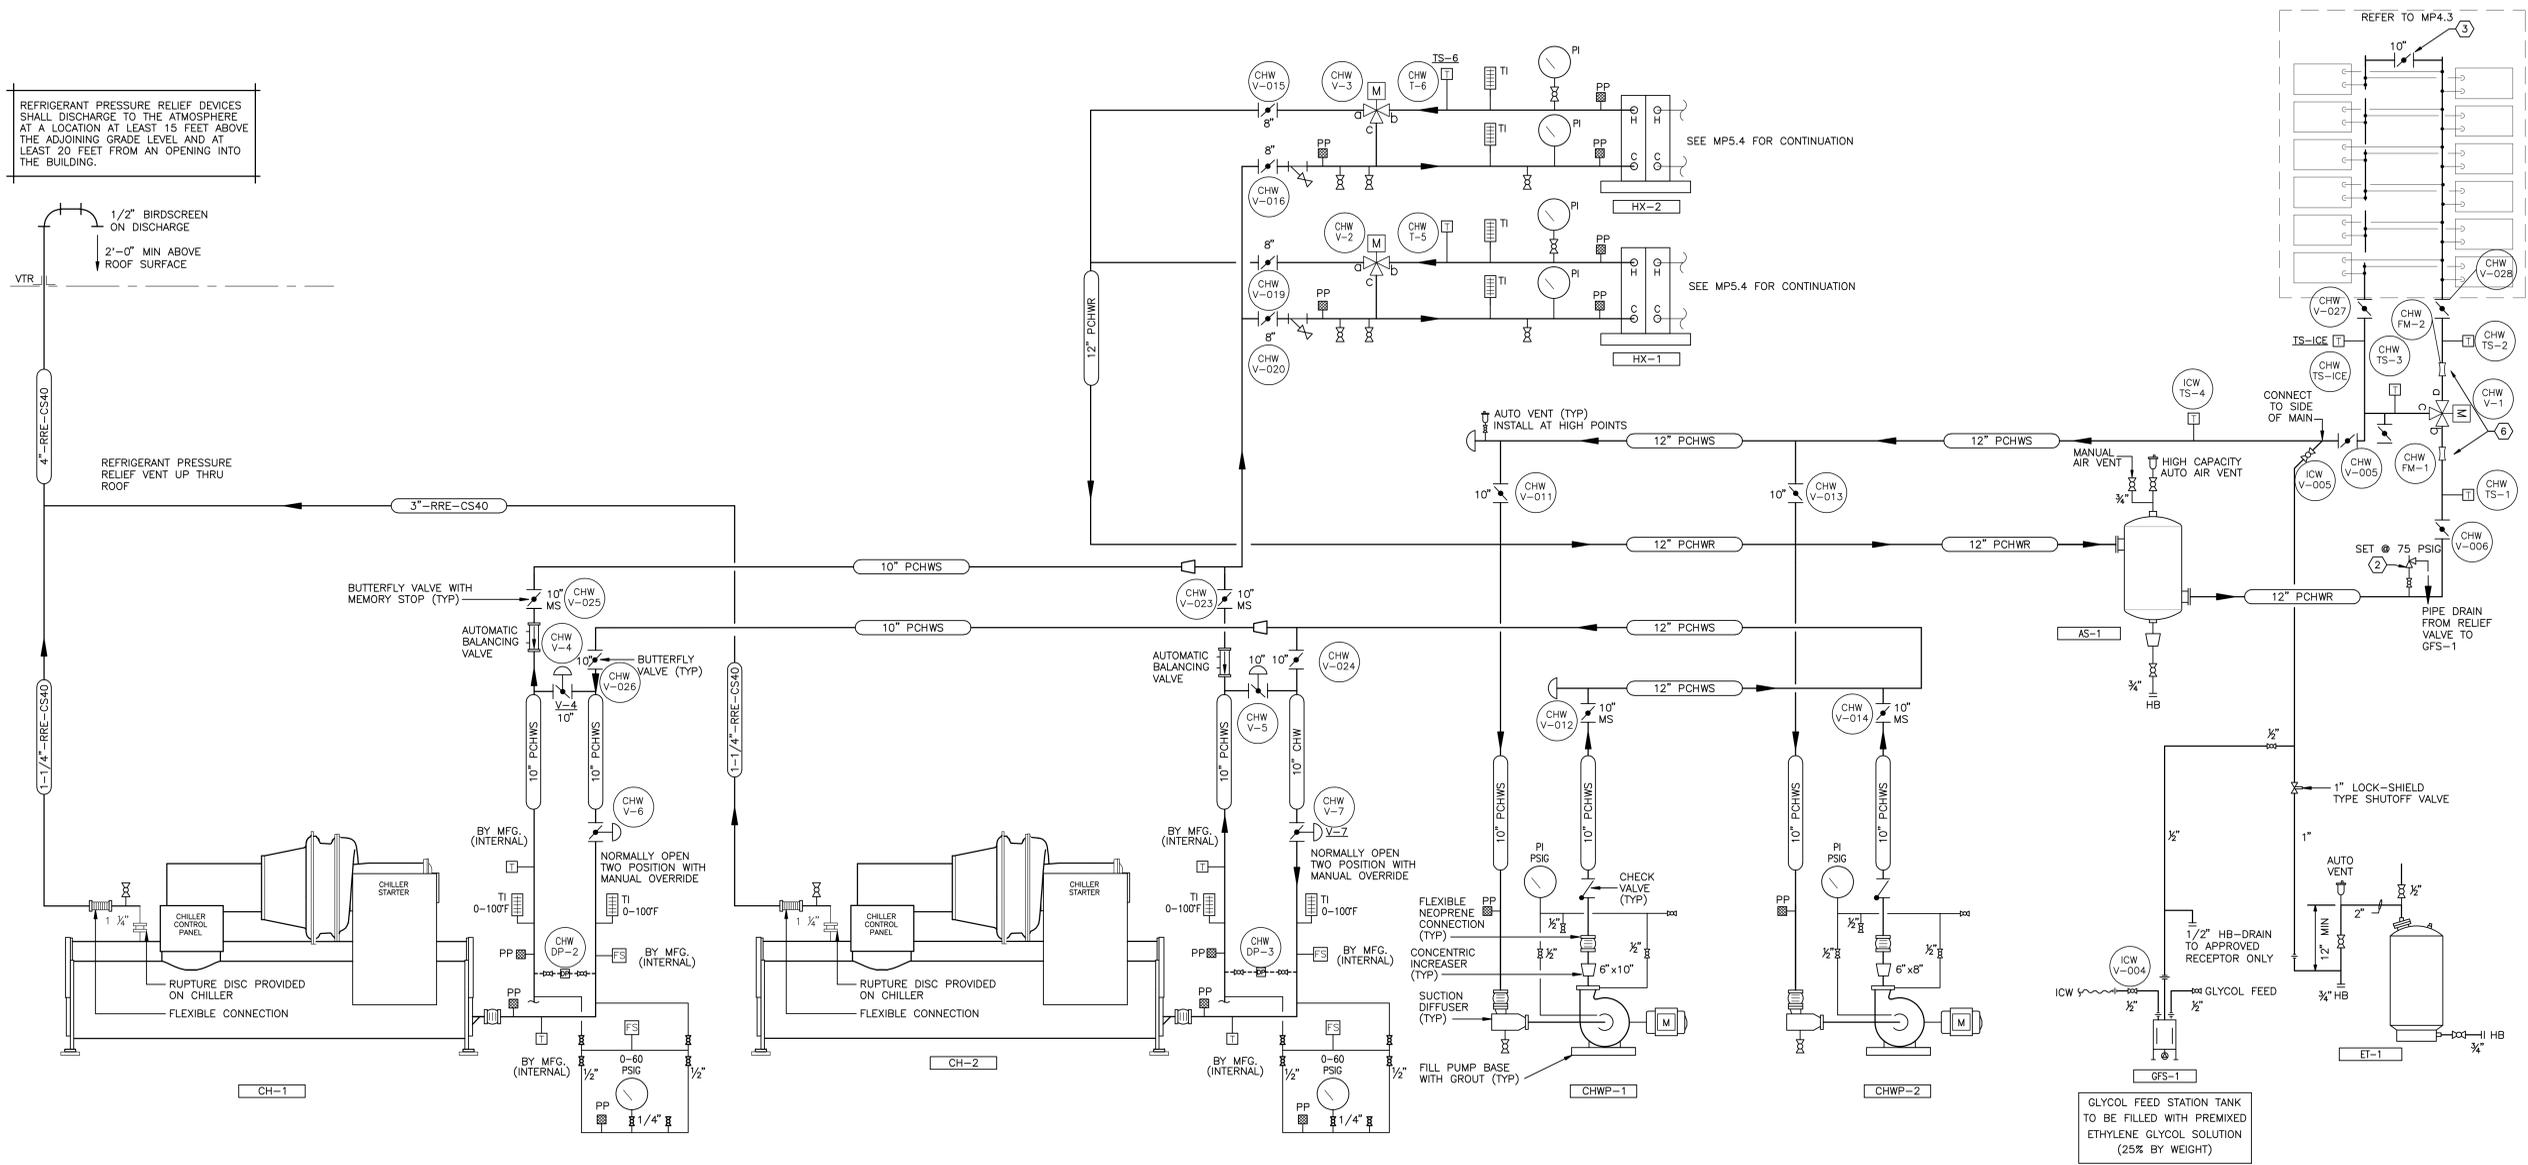

GLYCOL FEED STATION TANK TO BE FILLED WITH PREMIXED ETHYLENE GLYCOL SOLUTION (25% BY WEIGHT)

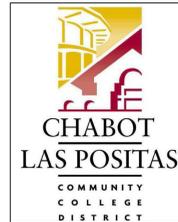

25555 HESPERIAN BLVD,
HAYWARD, CALIFORNIA

THE INCORPORATED STATE OF CALIFORNIA REGISTERED PROFESSIONAL ENGINEERS STAMP SERVES AS THE SELF CERTIFICATION FOR THESE DOCUMENTS.


SOUTHLAND INDUSTRIES



ALL DRAWINGS PREPARED BY SOUTHLAND INDUSTRIES ARE THE EXCLUSIVE PROPERTY OF SOUTHLAND INDUSTRIES AND, UNLESS OTHERWISE AGREED IN WRITING, SOUTHLAND INDUSTRIES SHALL BE DEEMED THE AUTHOR OF THEM AND SHALL RETAIN ALL COMMON LAW, STATUTORY AND OTHER RESERVED RIGHTS, IN ADDITION TO THE COPYRIGHT, ANY USE THEREOF WITHOUT THE EXPRESS WRITTEN CONSENT OF SOUTHLAND INDUSTRIES IS PROHIBITED



NO.	DESCRIPTION	DATE
0	DSA PERMIT SET	02/21/08
1	DSA BACK CHECK	06/26/08
2	AS BUILT	03/06/09

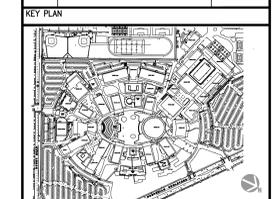

CHABOT COMMUNITY COLLEGE CENTRAL PLANT
25555 HESPERIAN BLVD,
HAYWARD, CALIFORNIA

SHEET TITLE
CHILLED WATER PIPING
DIAGRAM-SECONDARY


DRAWN BY SG17065	CHECKED BY MP5.4
PROJECT NO. 5517065	UNIT
SCALE	SHEET NO.
DATE 06-26-2008	

GENERAL NOTES

1. PROVIDE AUTOMATIC VENTING AT HIGH POINTS IN THE CHILLER WATER SYSTEM TO ELIMINATE ANY TRAPPED AIR. ROUTE DISCHARGE TO DRAIN.
2. DRAIN ALL LOW POINTS OF SYSTEMS AND RISERS TO NEAREST FLOOR DRAIN. ALL DRAINS ON PIPING 6" AND ABOVE SHALL BE 2" MIN.
3. WATER FLOW MEASURING DEVICES SHALL BE INSTALLED PER MANUFACTURER'S RECOMMENDATIONS.
4. SUPPORT PIPING INDEPENDENT OF EQUIPMENT.
5. ALL DRAIN CONNECTIONS FROM MECHANICAL EQUIPMENT SHALL BE PIPED TO SPILL INDIRECTLY INTO NEAREST FLOOR DRAIN.
6. INSTALL THERMOMETERS AND PRESSURE GAGES AT EYE LEVEL.
7. PROVIDE ELBOW SUPPORT AT ALL PIPE CONNECTIONS TO EQUIPMENT.
8. ALL MOTORIZED VALVES SHALL BE PROVIDED WITH LIMIT END SWITCHES FOR REMOTE SENSING OF POSITION INDICATION (FULL OPEN, FULL CLOSED, OR % OPEN). PROVIDE ALL APPURTENANCES NECESSARY FOR REMOTE MONITORING.

SHEET KEYNOTES

- ① PROVIDE 6 PIPE DIAMETERS OF STRAIGHT PIPE UP STREAM OR PUMP SUCTION.

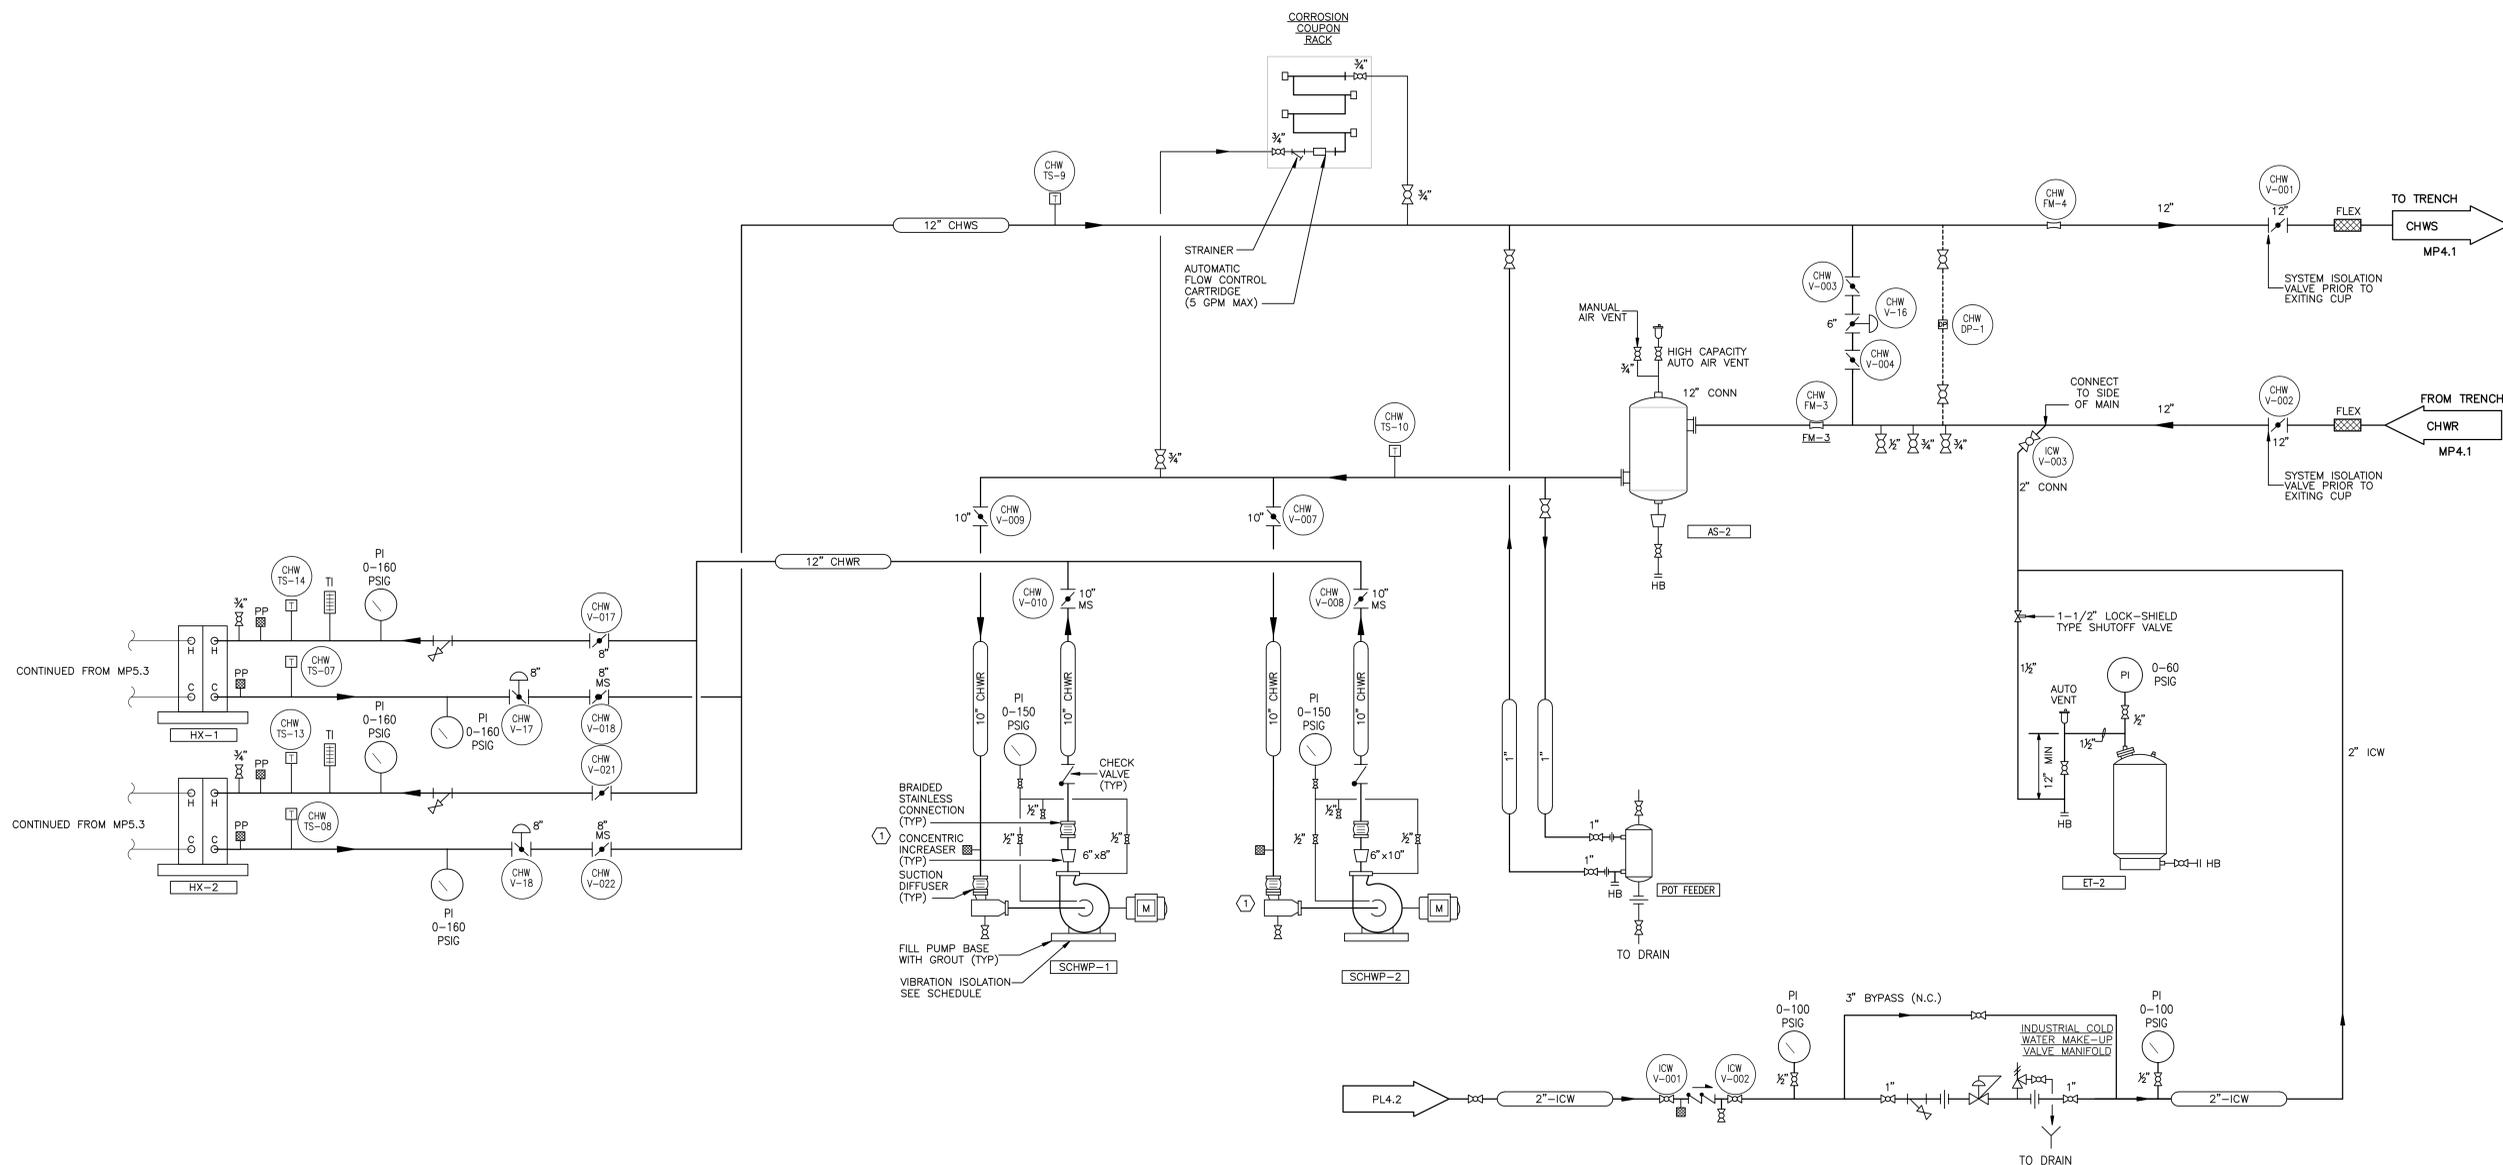

CHILLED WATER SYSTEM – SECONDARY SIDE



25555 HESPERIAN BLVD,
HAYWARD, CALIFORNIA

THE INCORPORATED STATE OF CALIFORNIA REGISTERED PROFESSIONAL ENGINEERS STAMP SERVES AS THE SELF CERTIFICATION FOR THESE DOCUMENTS.


SOUTHLAND INDUSTRIES

 775 Commercial Street
 San Jose, CA 95112
 Tel: 408-970-3777
 Fax: 408-970-3776

ALL DRAWINGS PREPARED BY SOUTHLAND INDUSTRIES ARE THE EXCLUSIVE PROPERTY OF SOUTHLAND INDUSTRIES AND, UNLESS OTHERWISE AGREED IN WRITING, SOUTHLAND INDUSTRIES SHALL BE DEEMED THE AUTHOR OF THEM AND SHALL RETAIN ALL COMMON LAW, STATUTORY AND OTHER RESERVED RIGHTS. IN ADDITION TO THE COPYRIGHT, ANY USE THEREOF WITHOUT THE EXPRESS WRITTEN CONSENT OF SOUTHLAND INDUSTRIES IS PROHIBITED




NO.	DESCRIPTION	DATE
-	50% CONSTRUCTION DOCUMENTS	06/31/07
-	90% CONSTRUCTION DOCUMENTS	09/21/07
-	ISSUED FOR CONSTRUCTION	11/05/07
-	AS-BUILT	03/06/09

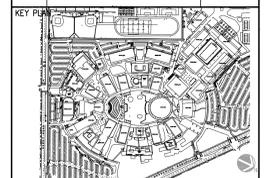

PROJECT TITLE
CHABOT COMMUNITY COLLEGE
CENTRAL PLANT PROJECT

SHEET TITLE
**PLUMBING OVERALL
SITE PLAN**

DRAWN BY PROJECT NO. 5617065	UNIT	CHECKED BY	SHEET NO.
SCALE: 1"=60'			PL1U.0
DATE 04-16-2007			

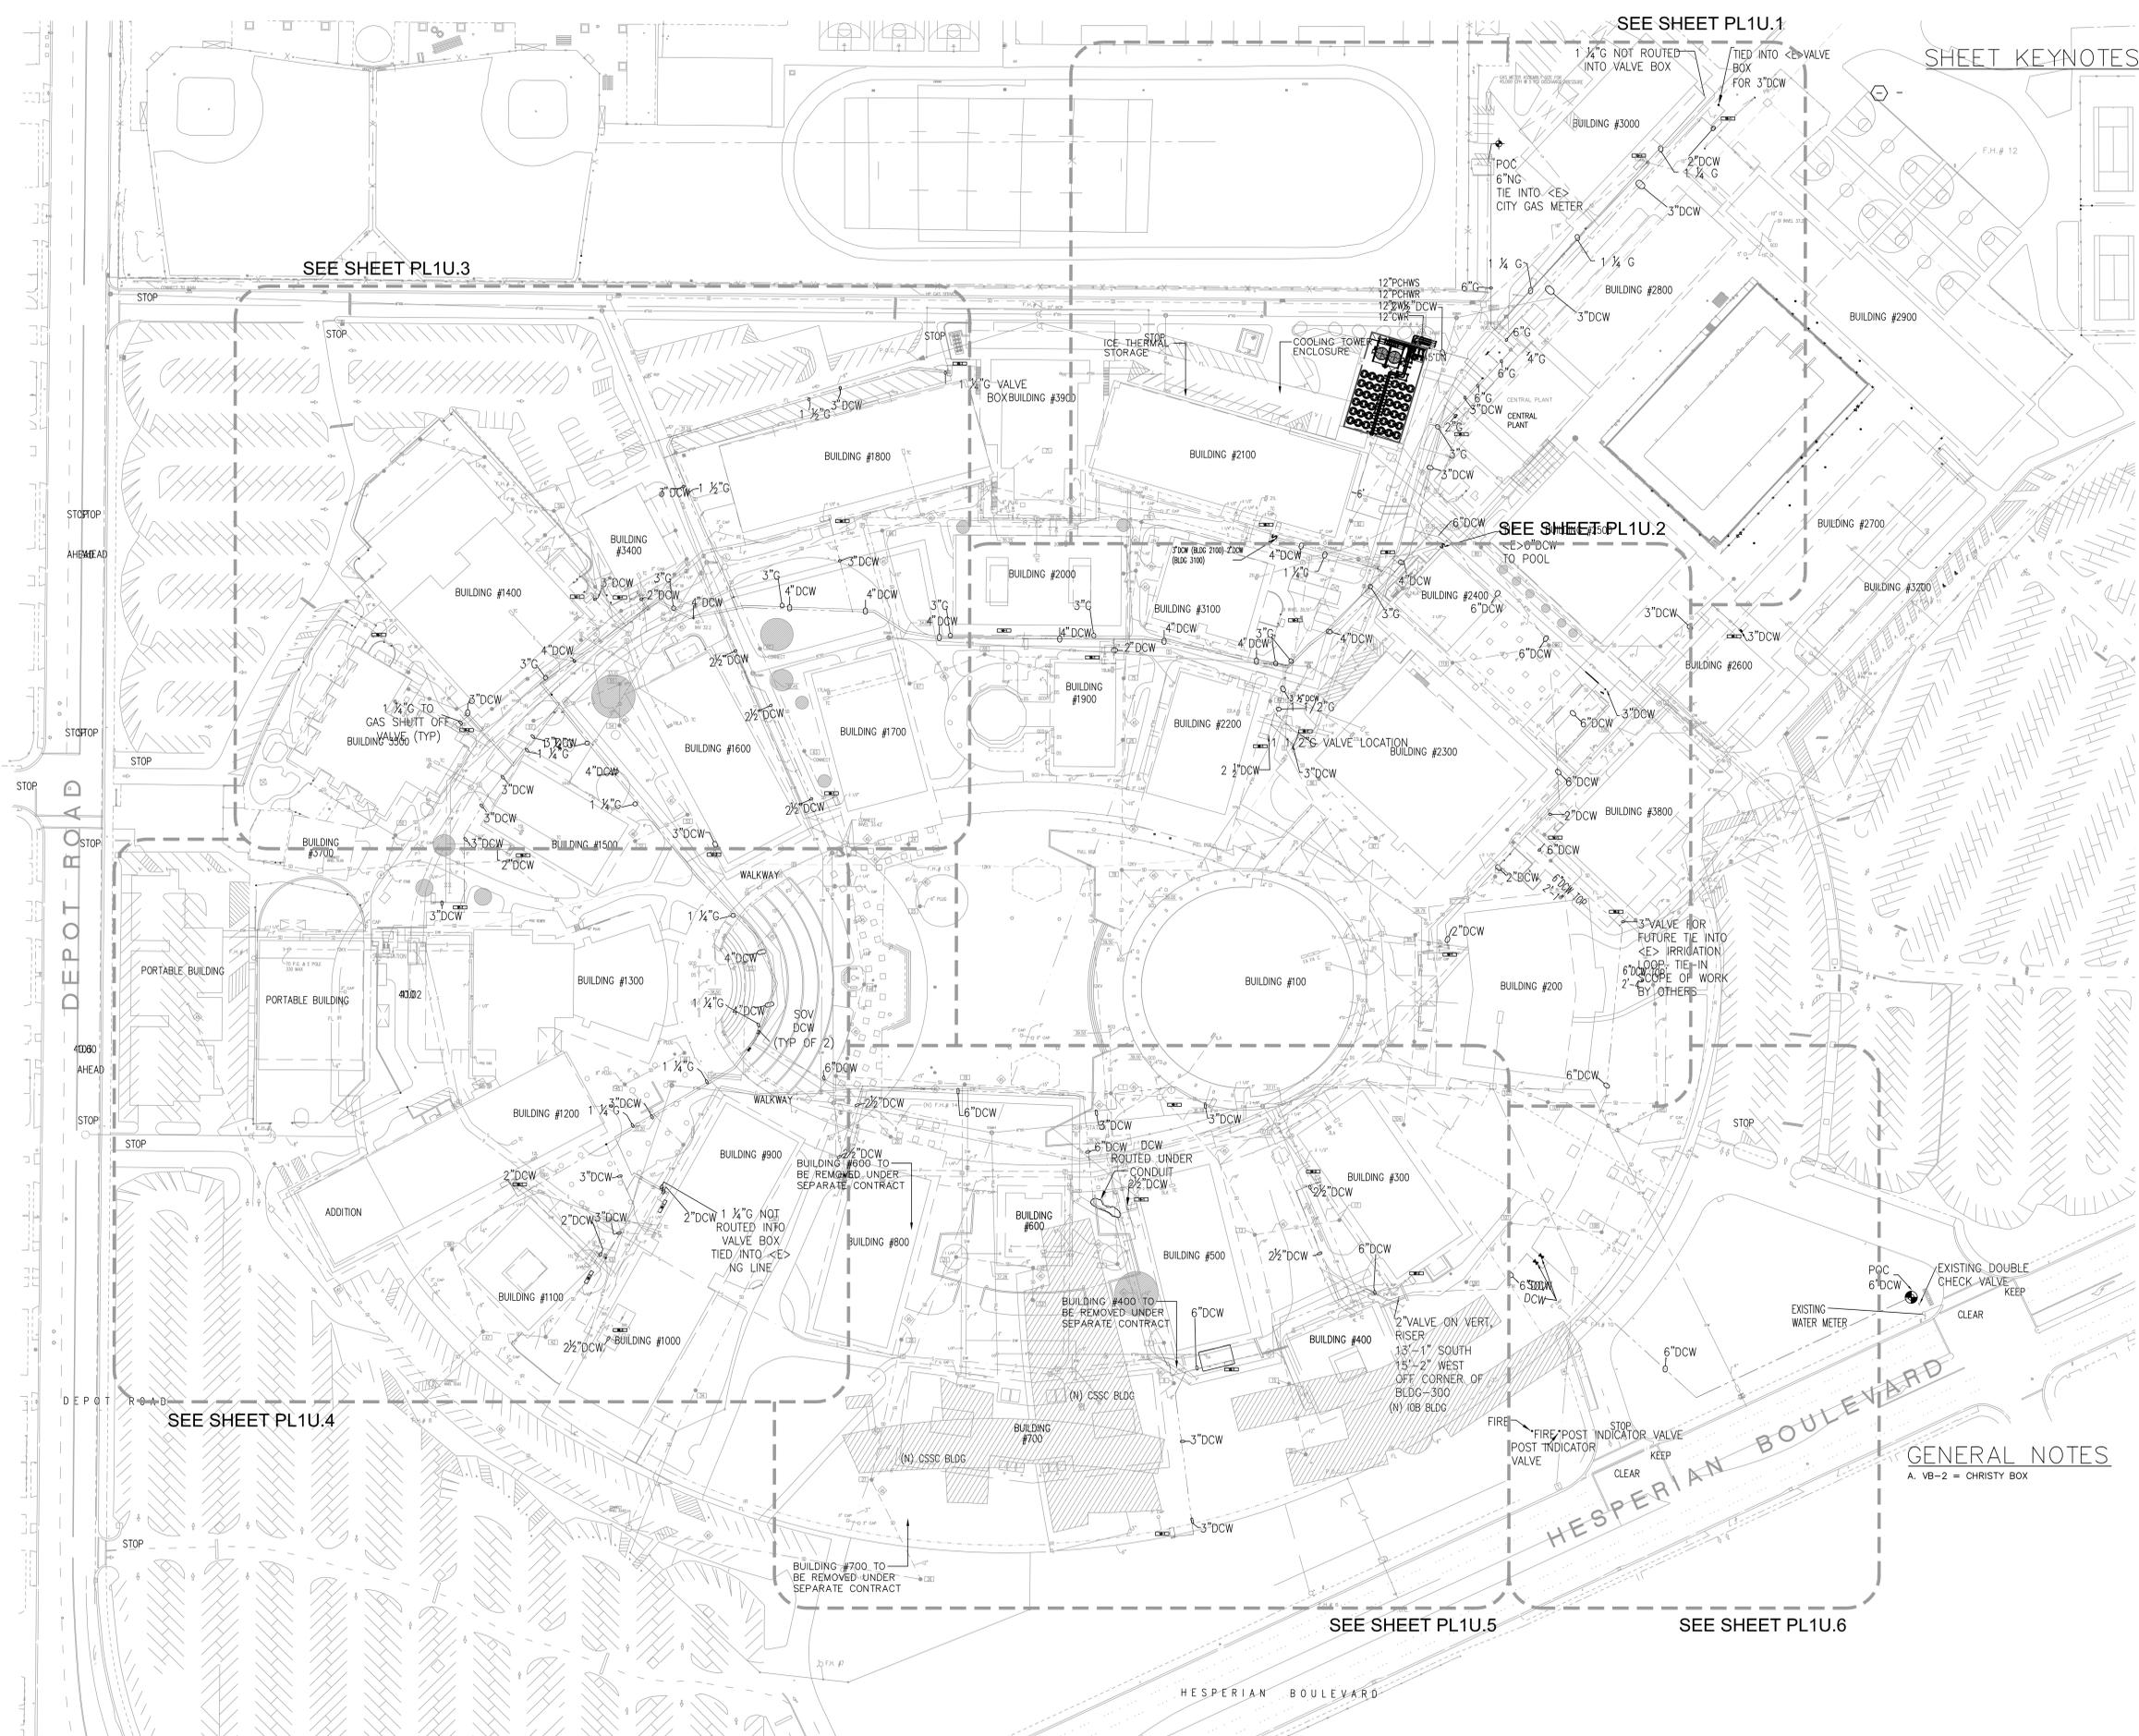

GENERAL NOTES
A. VB-2 = CHRISTY BOX

DEPOT ROAD

HESPERIAN BOULEVARD

SEE SHEET PL1U.3

SEE SHEET PL1U.1

SHEET KEYNOTES

SEE SHEET PL1U.2

SEE SHEET PL1U.4

SEE SHEET PL1U.5

SEE SHEET PL1U.6



25555 HESPERIAN BLVD,
HAYWARD, CALIFORNIA

THE INCORPORATED STATE OF CALIFORNIA REGISTERED PROFESSIONAL ENGINEERS STAMP SERVES AS THE SELF CERTIFICATION FOR THESE DOCUMENTS.

SOUTHLAND INDUSTRIES




775 Commercial Street
San Jose, CA 95112
Tel: 408-970.3777
Fax: 408-970.3776

ALL DRAWINGS PREPARED BY SOUTHLAND INDUSTRIES ARE THE EXCLUSIVE PROPERTY OF SOUTHLAND INDUSTRIES AND, UNLESS OTHERWISE AGREED IN WRITING, SOUTHLAND INDUSTRIES SHALL BE DEEMED THE AUTHOR OF THEM AND SHALL RETAIN ALL COMMON LAW, STATUTORY AND OTHER RESERVED RIGHTS. IN ADDITION TO THE COPYRIGHT, ANY USE THEREOF WITHOUT THE EXPRESS WRITTEN CONSENT OF SOUTHLAND INDUSTRIES IS PROHIBITED




NO.	DESCRIPTION	DATE
-	50% CONSTRUCTION DOCUMENTS	08/31/07
-	90% CONSTRUCTION DOCUMENTS	09/21/07
-	ISSUED FOR CONSTRUCTION	11/05/07
-	AS-BUILT	03/06/09

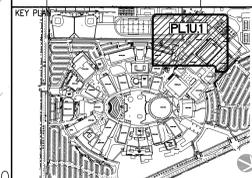


PROJECT TITLE
CHABOT COMMUNITY COLLEGE
CENTRAL PLANT PROJECT

SHEET TITLE
**PARTIAL PLUMBING
PLAN**

DRAWN BY PROJECT NO. 5617065	CHECKED BY	UNIT	SHEET NO.
SCALE: 1"=20'			PL1U.1
DATE 04-16-2007			

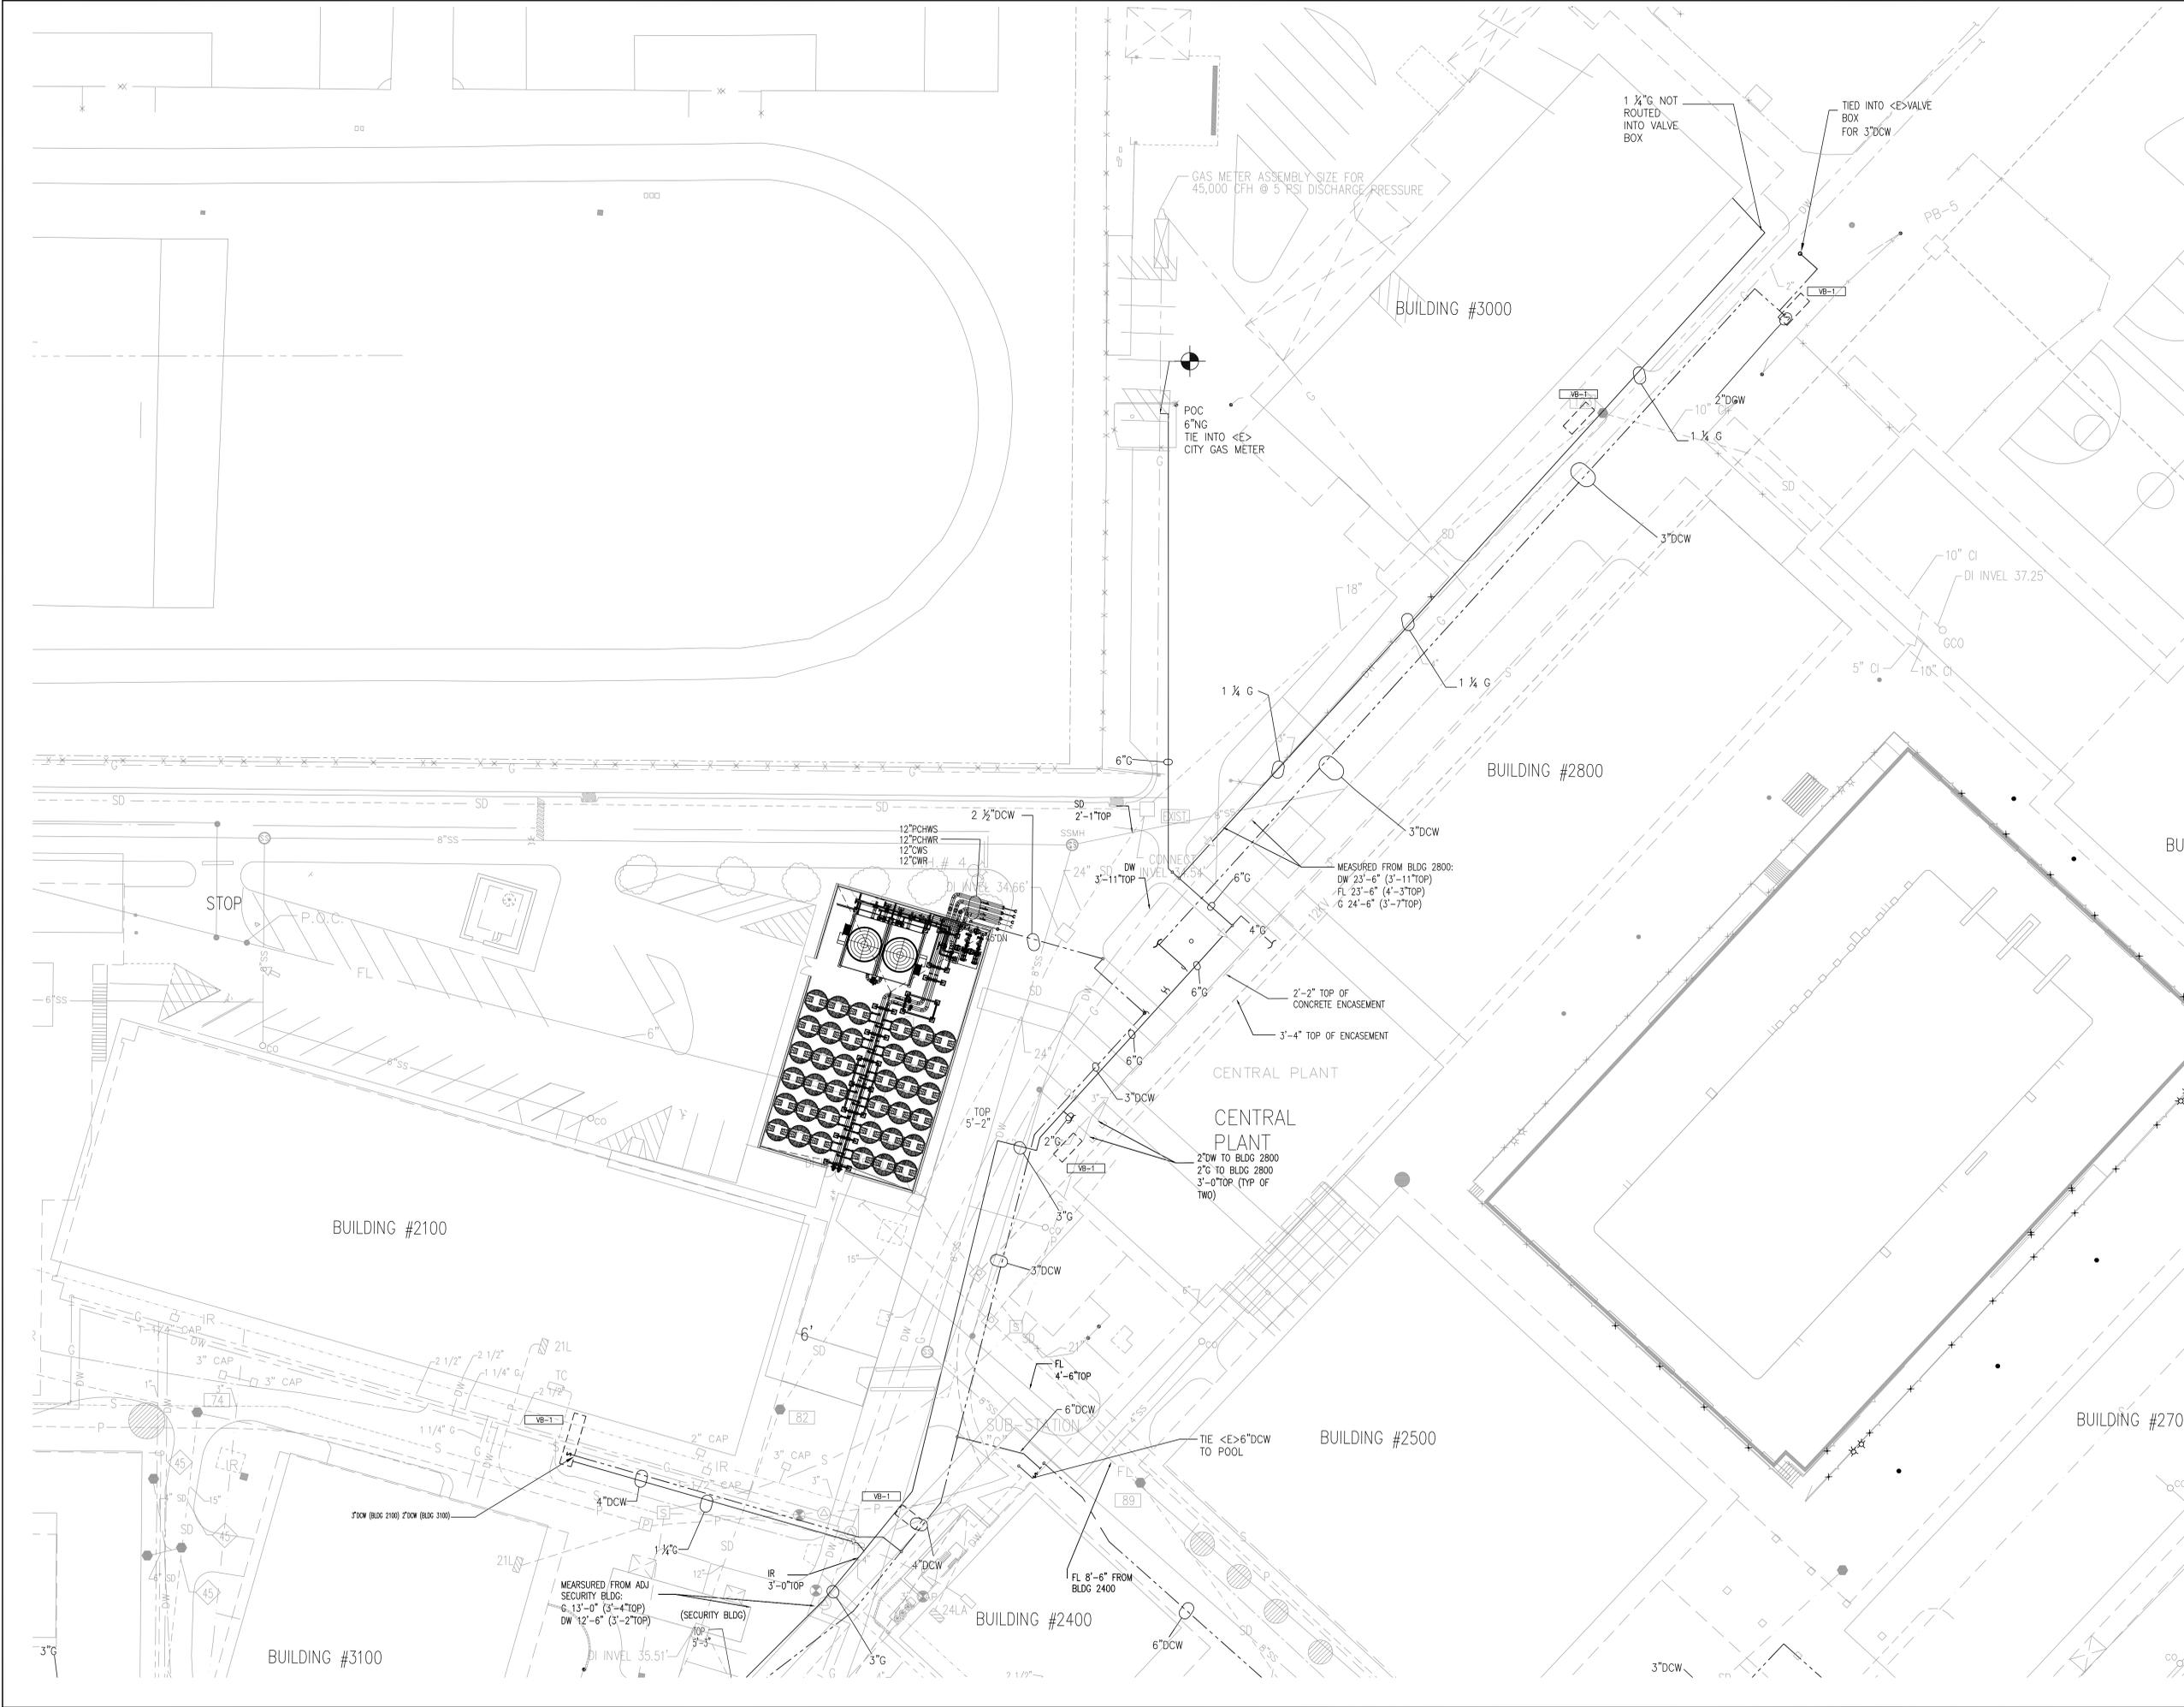

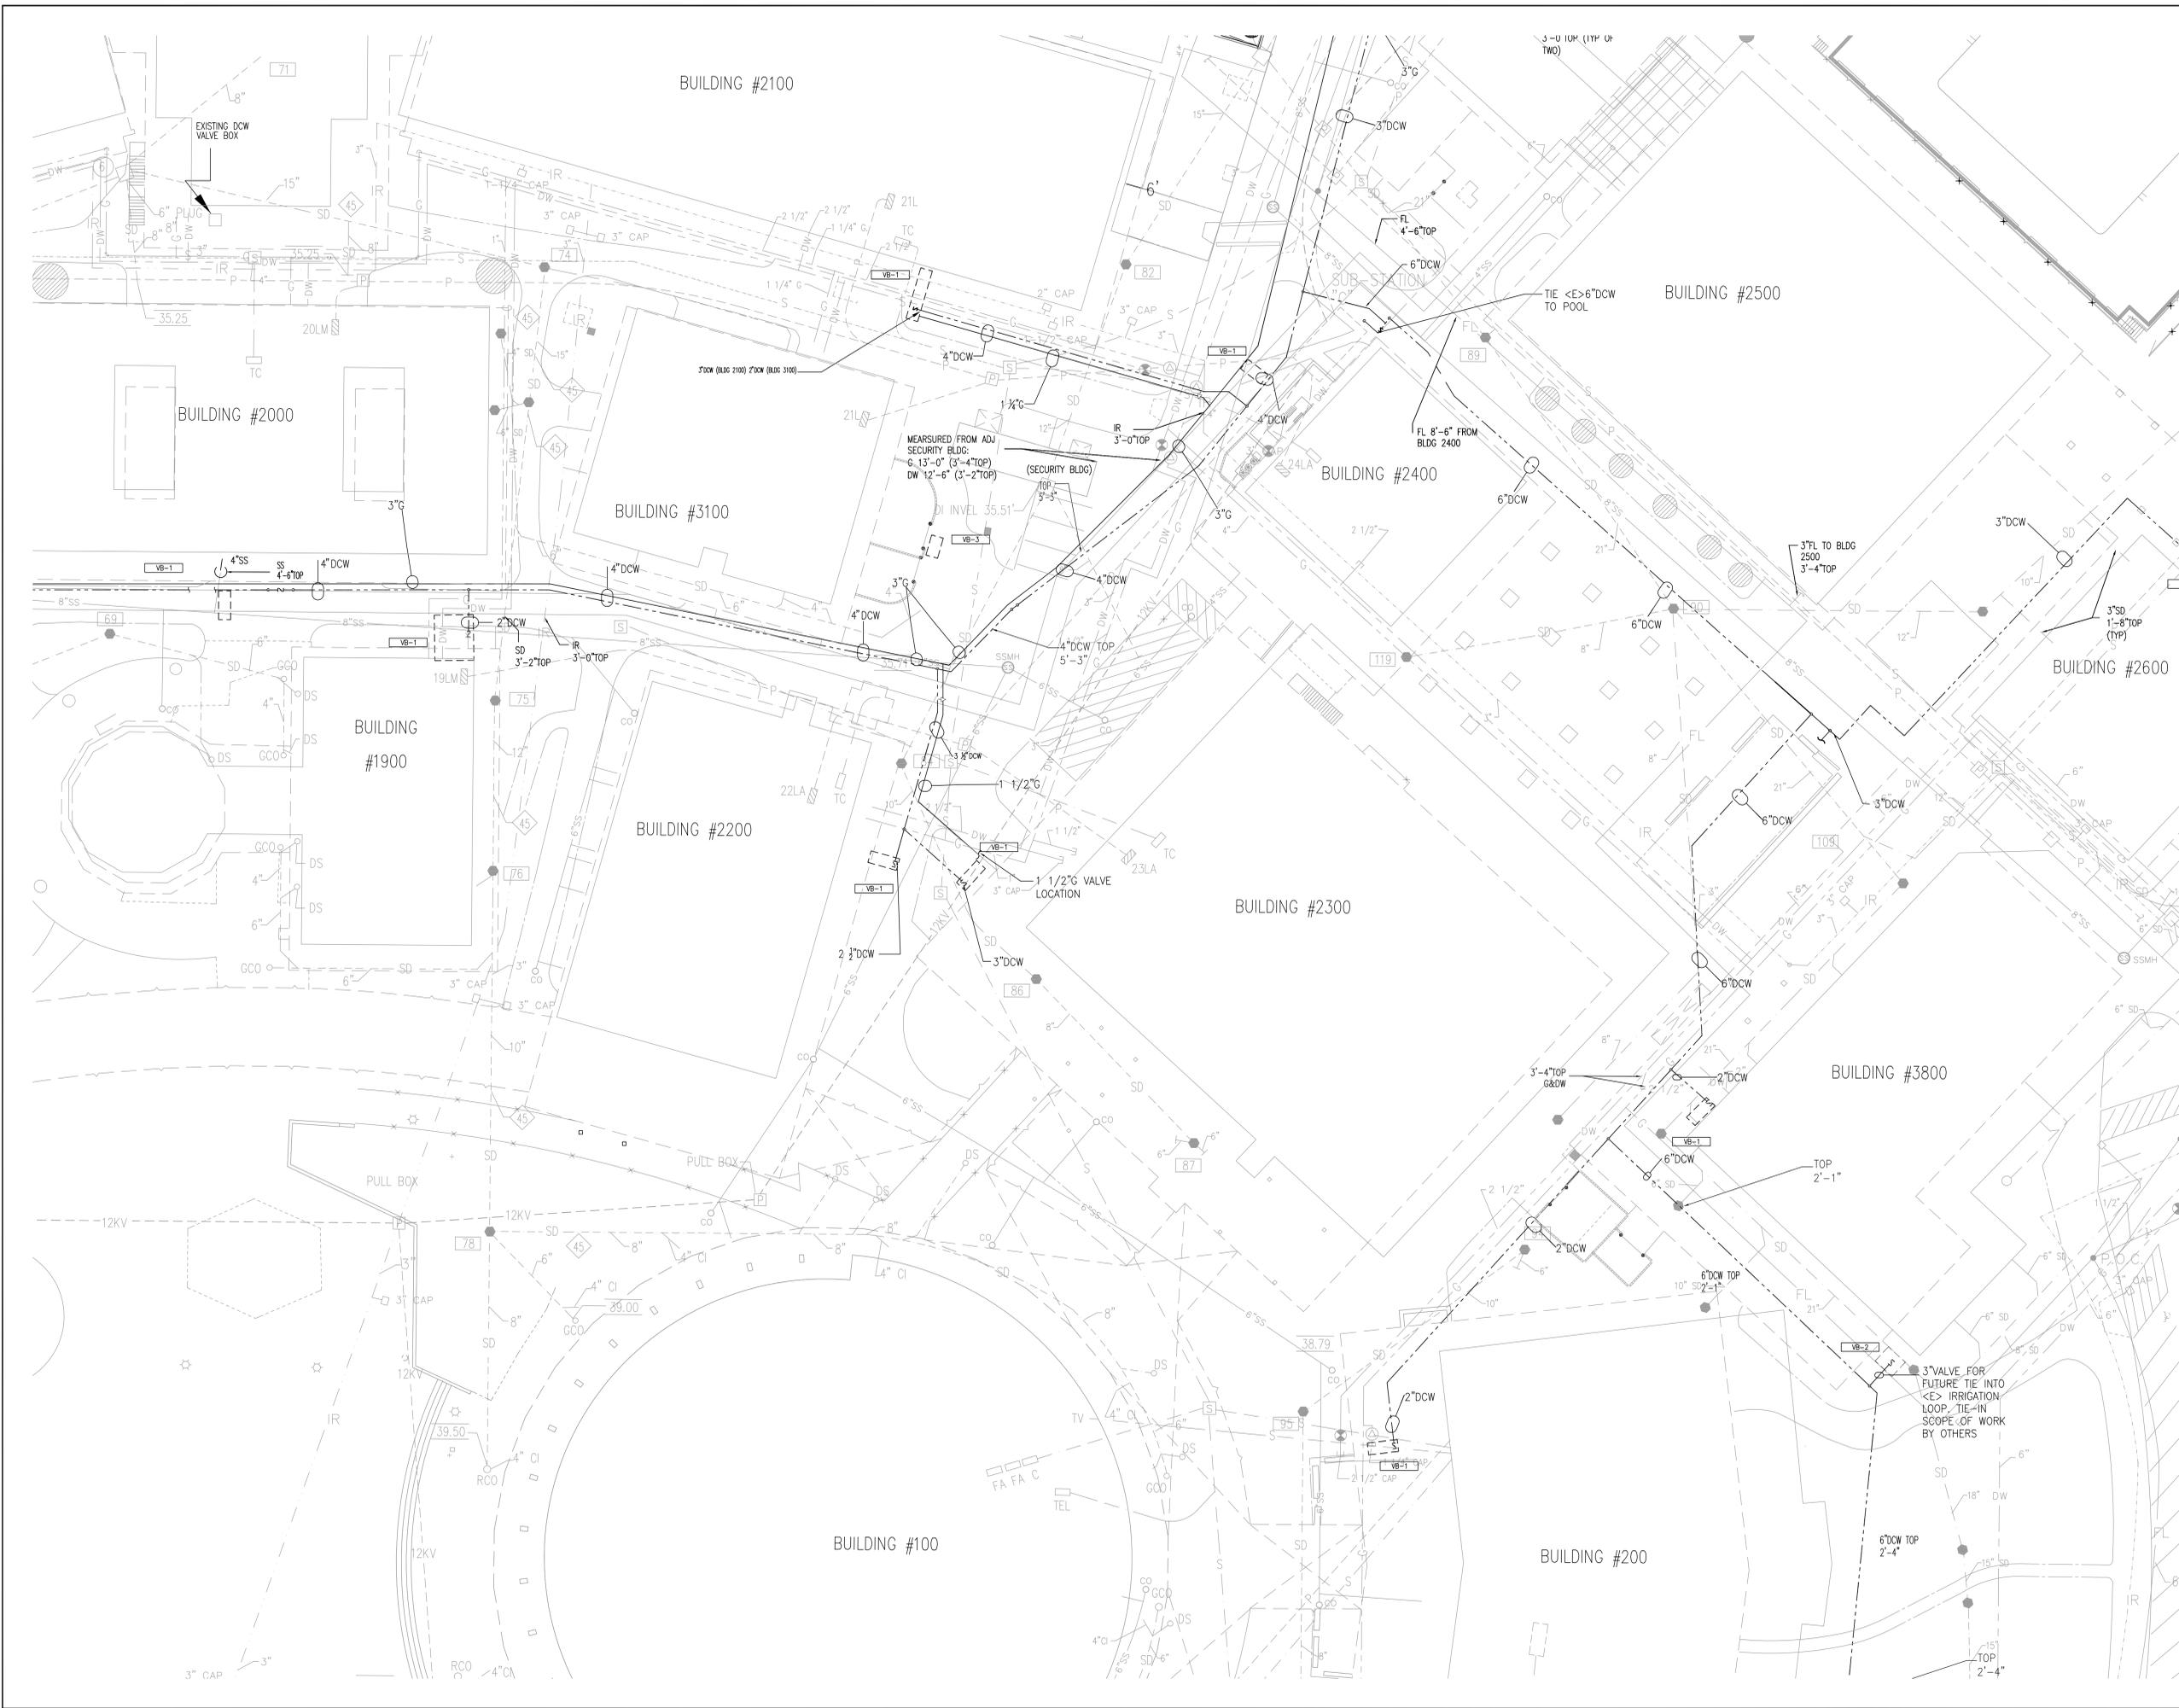

25555 HESPERIAN BLVD,
HAYWARD, CALIFORNIA

THE INCORPORATED STATE OF CALIFORNIA REGISTERED PROFESSIONAL ENGINEERS STAMP SERVES AS THE SELF CERTIFICATION FOR THESE DOCUMENTS.

SOUTHLAND INDUSTRIES
 775 Commercial Street
 San Jose, CA 95112
 Tel: 408-970-3777
 Fax: 408-970-3776

ALL DRAWINGS PREPARED BY SOUTHLAND INDUSTRIES ARE THE EXCLUSIVE PROPERTY OF SOUTHLAND INDUSTRIES AND, UNLESS OTHERWISE AGREED IN WRITING, SOUTHLAND INDUSTRIES SHALL BE DEEMED THE AUTHOR OF THEM AND SHALL RETAIN ALL COMMON LAW, STATUTORY AND OTHER RESERVED RIGHTS. IN ADDITION TO THE COPYRIGHT, ANY USE THEREOF WITHOUT THE EXPRESS WRITTEN CONSENT OF SOUTHLAND INDUSTRIES IS PROHIBITED




NO.	DESCRIPTION	DATE
-	50% CONSTRUCTION DOCUMENTS	06/31/07
-	90% CONSTRUCTION DOCUMENTS	09/21/07
-	ISSUED FOR CONSTRUCTION	11/05/07
-	AS-BUILT	03/06/09



PROJECT TITLE
**CHABOT COMMUNITY COLLEGE
 CENTRAL PLANT PROJECT**

SHEET TITLE
**PARTIAL PLUMBING
 PLAN**

DRAWN BY PROJECT NO. 5617065	CHECKED BY	UNIT	SHEET NO.
SCALE: 1"=20'			PL1U.2
DATE 04-16-2007			

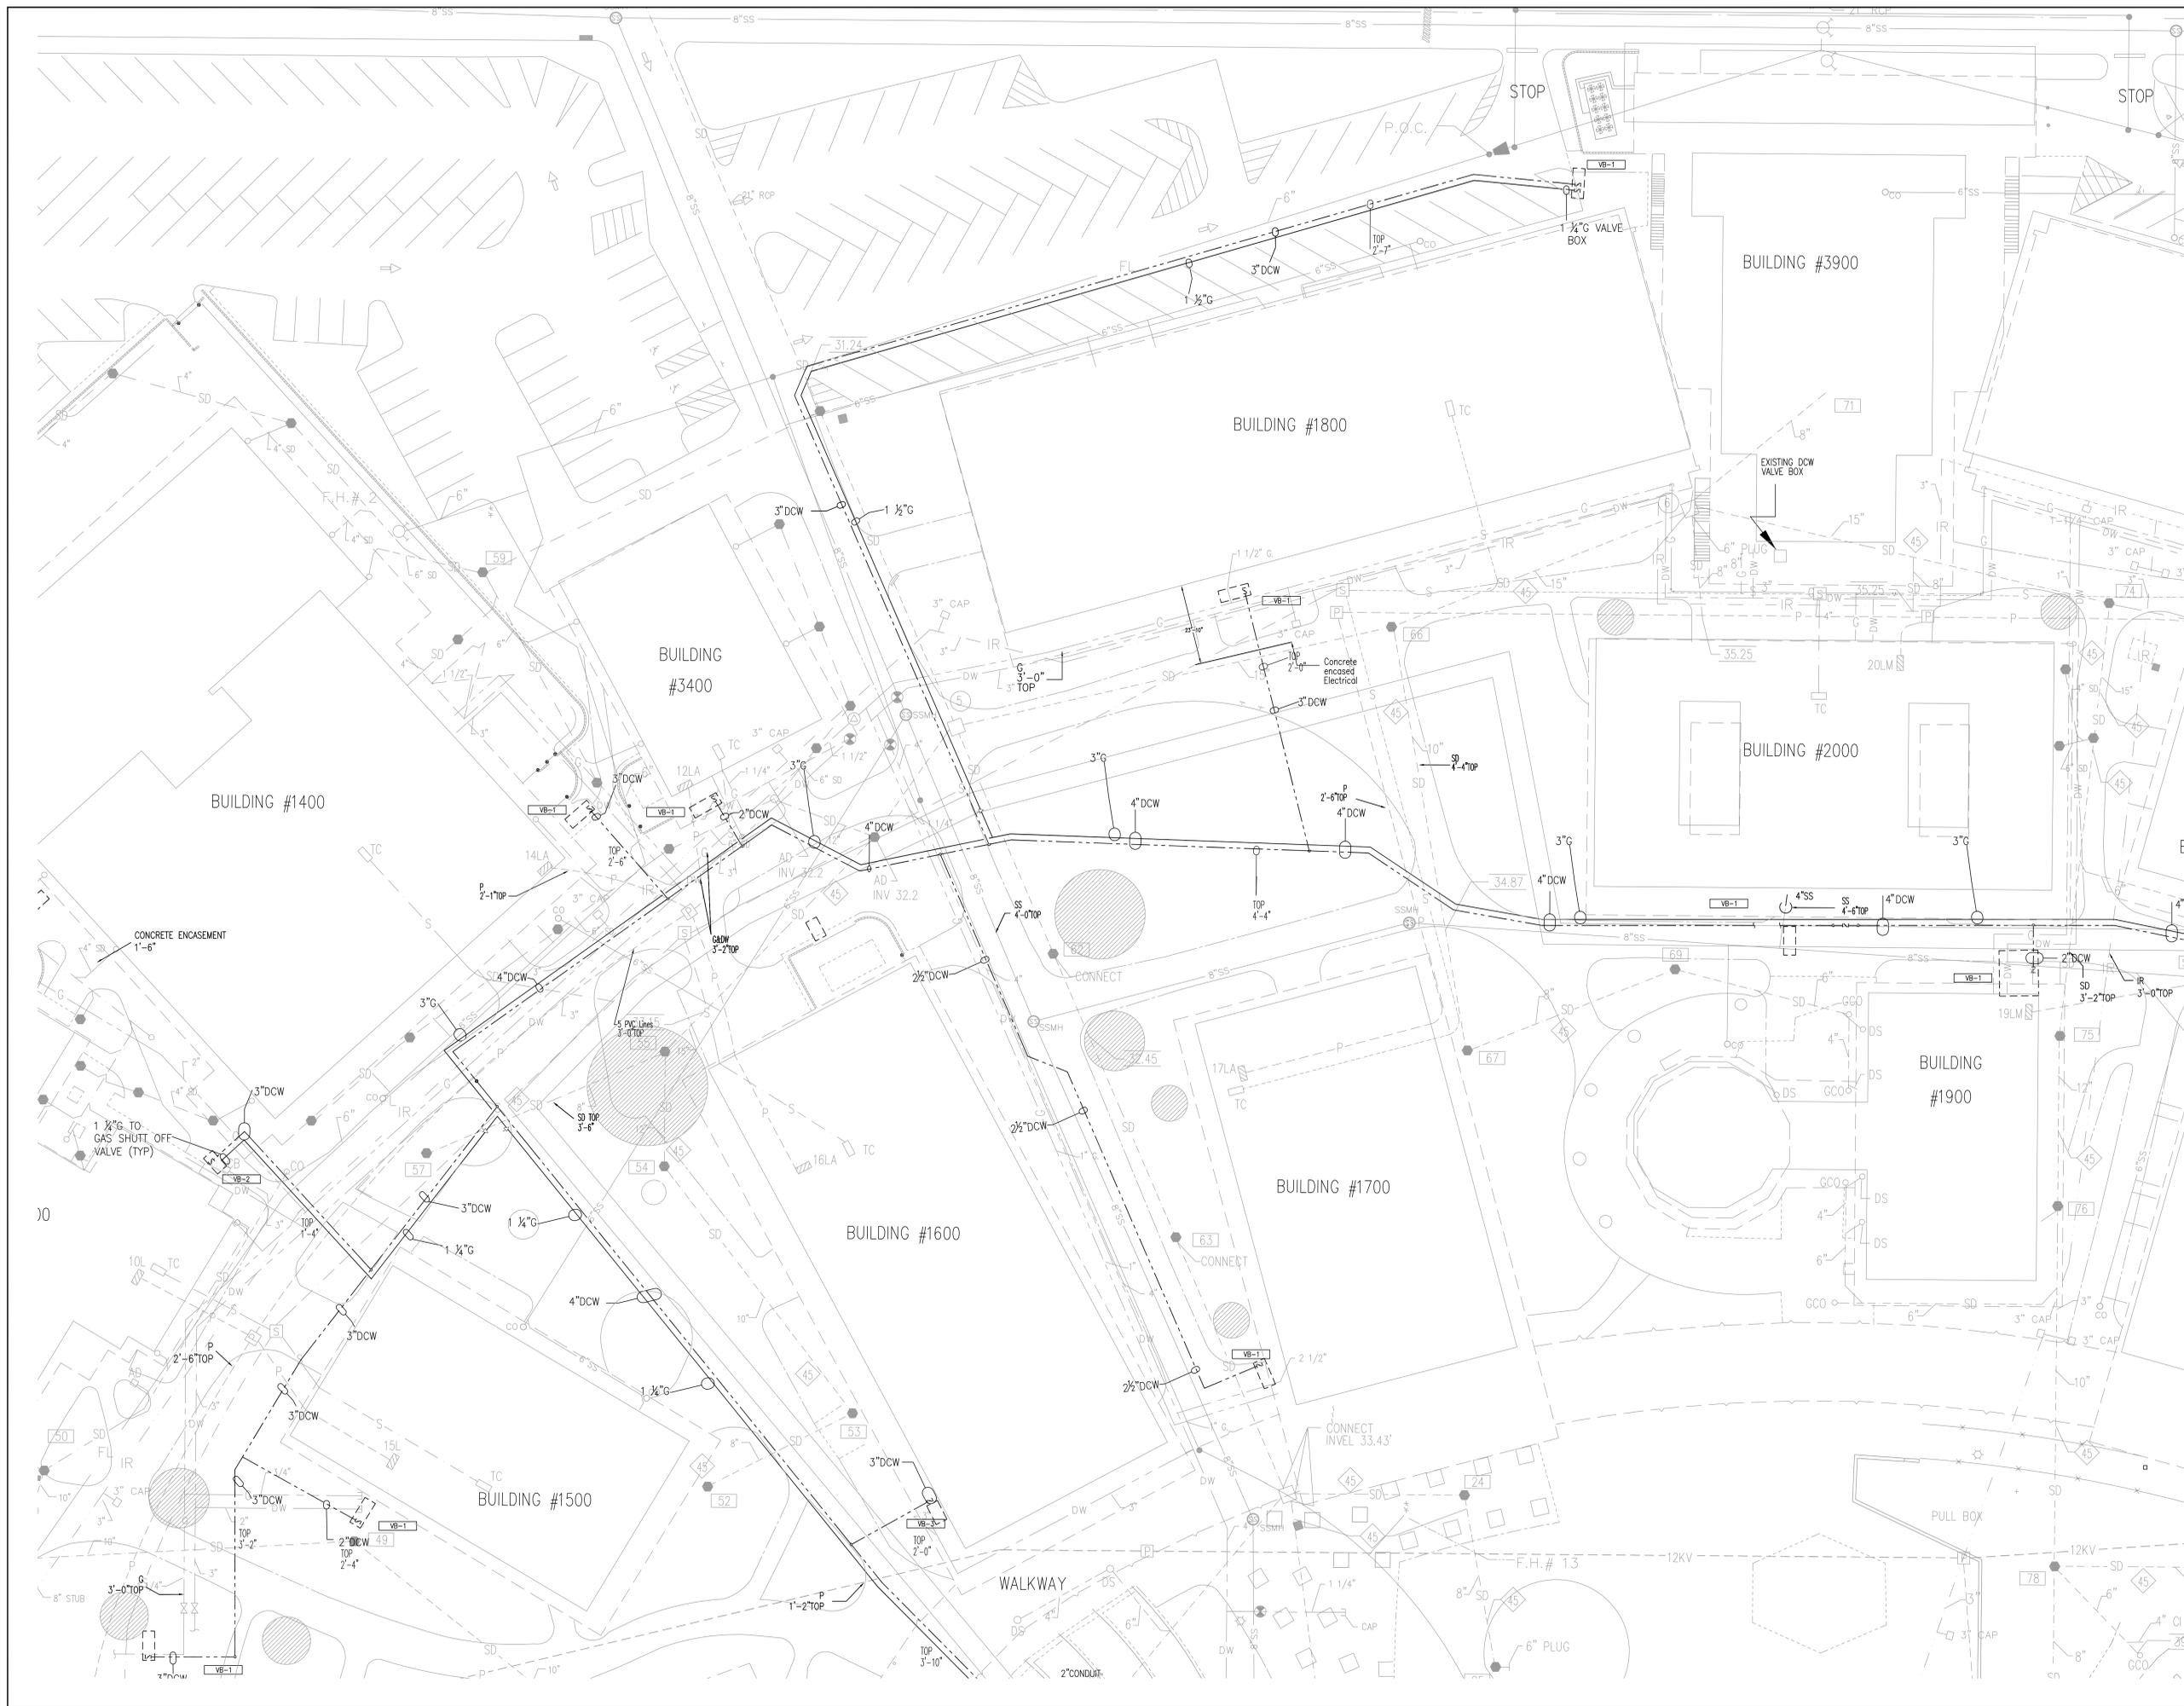

25555 HESPERIAN BLVD,
HAYWARD, CALIFORNIA

THE INCORPORATED STATE OF CALIFORNIA REGISTERED PROFESSIONAL ENGINEERS STAMP SERVES AS THE SELF CERTIFICATION FOR THESE DOCUMENTS.

SOUTHLAND INDUSTRIES



775 Commercial Street
San Jose, CA 95112
Tel: 408.970.3777
Fax: 408.970.3776

ALL DRAWINGS PREPARED BY SOUTHLAND INDUSTRIES ARE THE EXCLUSIVE PROPERTY OF SOUTHLAND INDUSTRIES AND, UNLESS OTHERWISE AGREED IN WRITING, SOUTHLAND INDUSTRIES SHALL BE DEEMED THE AUTHOR OF THEM AND SHALL RETAIN ALL COMMON LAW, STATUTORY AND OTHER RESERVED RIGHTS. IN ADDITION TO THE COPYRIGHT, ANY USE THEREOF WITHOUT THE EXPRESS WRITTEN CONSENT OF SOUTHLAND INDUSTRIES IS PROHIBITED



NO.	DESCRIPTION	DATE
-	50% CONSTRUCTION DOCUMENTS	06/31/07
-	90% CONSTRUCTION DOCUMENTS	09/21/07
-	ISSUED FOR CONSTRUCTION	11/05/07
-	AS-BUILT	03/06/09



PROJECT TITLE
CHABOT COMMUNITY COLLEGE
CENTRAL PLANT PROJECT

SHEET TITLE
PARTIAL PLUMBING PLAN

DRAWN BY PROJECT NO. 5617065	UNIT	CHECKED BY	SHEET NO.
SCALE: 1"=20'			PLU13
DATE 04-16-2007			



25555 HESPERIAN BLVD,
HAYWARD, CALIFORNIA

THE INCORPORATED STATE OF CALIFORNIA REGISTERED PROFESSIONAL ENGINEERS STAMP SERVES AS THE SELF CERTIFICATION FOR THESE DOCUMENTS.

SOUTHLAND INDUSTRIES




775 Commercial Street
San Jose, CA 95112
Tel: 408-970-3777
Fax: 408-970-3776

ALL DRAWINGS PREPARED BY SOUTHLAND INDUSTRIES ARE THE EXCLUSIVE PROPERTY OF SOUTHLAND INDUSTRIES AND, UNLESS OTHERWISE AGREED IN WRITING, SOUTHLAND INDUSTRIES SHALL BE DEEMED THE AUTHOR OF THEM AND SHALL RETAIN ALL COMMON LAW, STATUTORY AND OTHER RESERVED RIGHTS. IN ADDITION TO THE COPYRIGHT, ANY USE THEREOF WITHOUT THE EXPRESS WRITTEN CONSENT OF SOUTHLAND INDUSTRIES IS PROHIBITED




NO.	DESCRIPTION	DATE
-	50% CONSTRUCTION DOCUMENTS	06/31/07
-	90% CONSTRUCTION DOCUMENTS	09/21/07
-	ISSUED FOR CONSTRUCTION	11/05/07
-	AS-BUILT	03/06/09

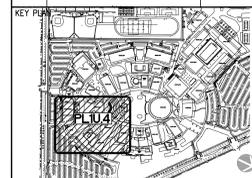

PROJECT TITLE
CHABOT COMMUNITY COLLEGE
CENTRAL PLANT PROJECT

SHEET TITLE
**PARTIAL PLUMBING
PLAN**

DRAWN BY PROJECT NO. 5617065	UNIT	CHECKED BY	SHEET NO.
SCALE: 1"=20'			PLU.4
DATE 04-16-2007			

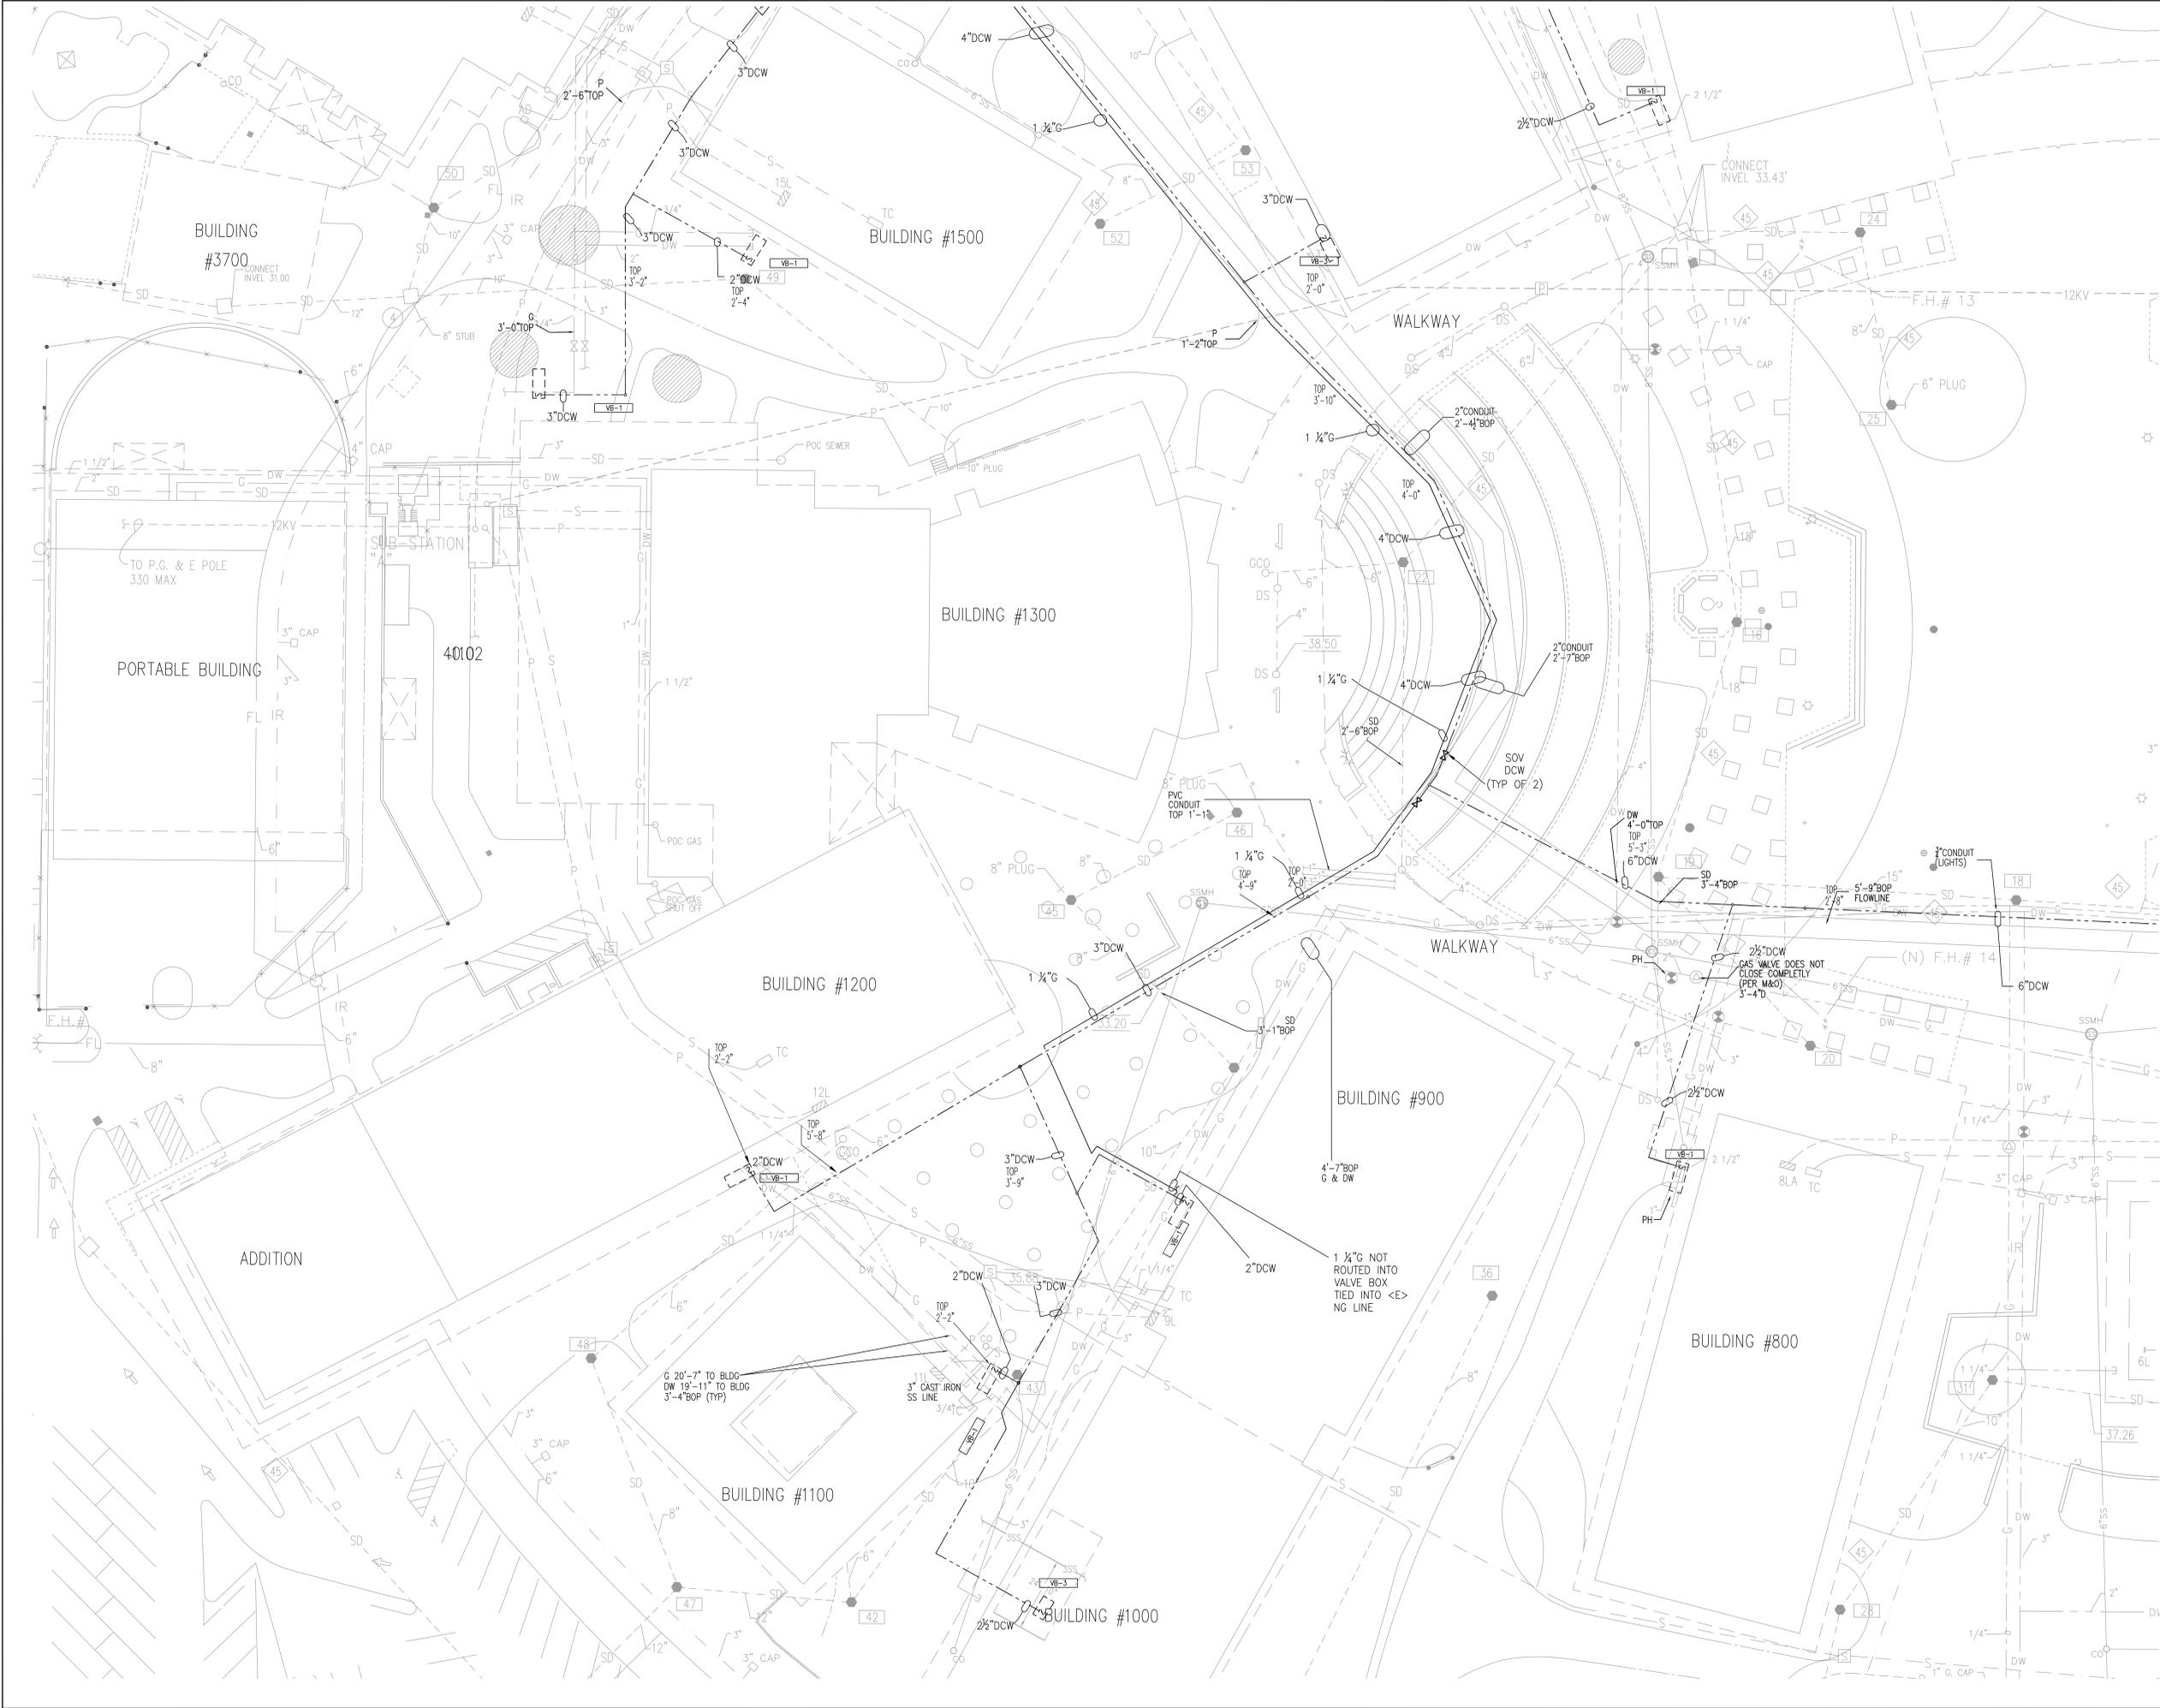



25555 HESPERIAN BLVD,
HAYWARD, CALIFORNIA


THE INCORPORATED STATE OF CALIFORNIA REGISTERED PROFESSIONAL ENGINEERS STAMP SERVES AS THE SELF CERTIFICATION FOR THESE DOCUMENTS.

SOUTHLAND INDUSTRIES
 775 Commercial Street
 San Jose, CA 95112
 Tel: 408-970.3777
 Fax: 408-970.3776

ALL DRAWINGS PREPARED BY SOUTHLAND INDUSTRIES ARE THE EXCLUSIVE PROPERTY OF SOUTHLAND INDUSTRIES AND, UNLESS OTHERWISE AGREED IN WRITING, SOUTHLAND INDUSTRIES SHALL BE DEEMED THE AUTHOR OF THEM AND SHALL RETAIN ALL COMMON LAW, STATUTORY AND OTHER RESERVED RIGHTS. IN ADDITION TO THE COPYRIGHT, ANY USE THEREOF WITHOUT THE EXPRESS WRITTEN CONSENT OF SOUTHLAND INDUSTRIES IS PROHIBITED



NO.	DESCRIPTION	DATE
-	50% CONSTRUCTION DOCUMENTS	06/31/07
-	90% CONSTRUCTION DOCUMENTS	09/21/07
-	ISSUED FOR CONSTRUCTION	11/05/07
-	AS-BUILT	03/06/09

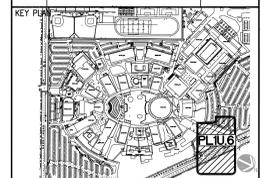

PROJECT TITLE
 CHABOT COMMUNITY COLLEGE
 CENTRAL PLANT PROJECT

SHEET TITLE
**PARTIAL PLUMBING
 PLAN**

DRAWN BY	UNIT	CHECKED BY	SHEET NO.
PROJECT NO. 5617065			PL1U.6
SCALE: 1"=20'			
DATE 04-16-2007			

SHEET KEYNOTES




25555 HESPERIAN BLVD,
HAYWARD, CALIFORNIA

THE INCORPORATED STATE OF CALIFORNIA REGISTERED PROFESSIONAL ENGINEERS STAMP SERVES AS THE SELF CERTIFICATION FOR THESE DOCUMENTS.



ALL DRAWINGS PREPARED BY SOUTHLAND INDUSTRIES ARE THE EXCLUSIVE PROPERTY OF SOUTHLAND INDUSTRIES AND, UNLESS OTHERWISE AGREED IN WRITING, SOUTHLAND INDUSTRIES SHALL BE DEEMED THE AUTHOR OF THEM AND SHALL RETAIN ALL COMMON LAW, STATUTORY AND OTHER RESERVED RIGHTS, IN ADDITION TO THE COPYRIGHT. ANY USE THEREOF WITHOUT THE EXPRESS WRITTEN CONSENT OF SOUTHLAND INDUSTRIES IS PROHIBITED


NO.	DESCRIPTION	DATE
0	DSA PERMIT SET	02/21/08
1	DSA BACK CHECK	06/26/08
2	FIRE DEPT PERMIT SET	09/03/08
3	AS-BUILT	02/18/09

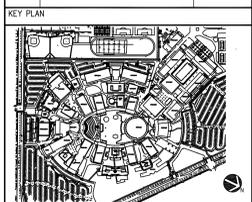

PROJECT TITLE
CHABOT COMMUNITY COLLEGE CENTRAL PLANT
25555 HESPERIAN BLVD,
HAYWARD, CALIFORNIA

SHEET TITLE
BUILDING 2800
ENLARGED PARTIAL PLUMBING UNDERGROUND PLAN

DRAWN BY C. Garcia	CHECKED BY
PROJECT NO. 5617065	UNIT
SCALE:	SHEET NO. PL41
DATE 06-26-2008	

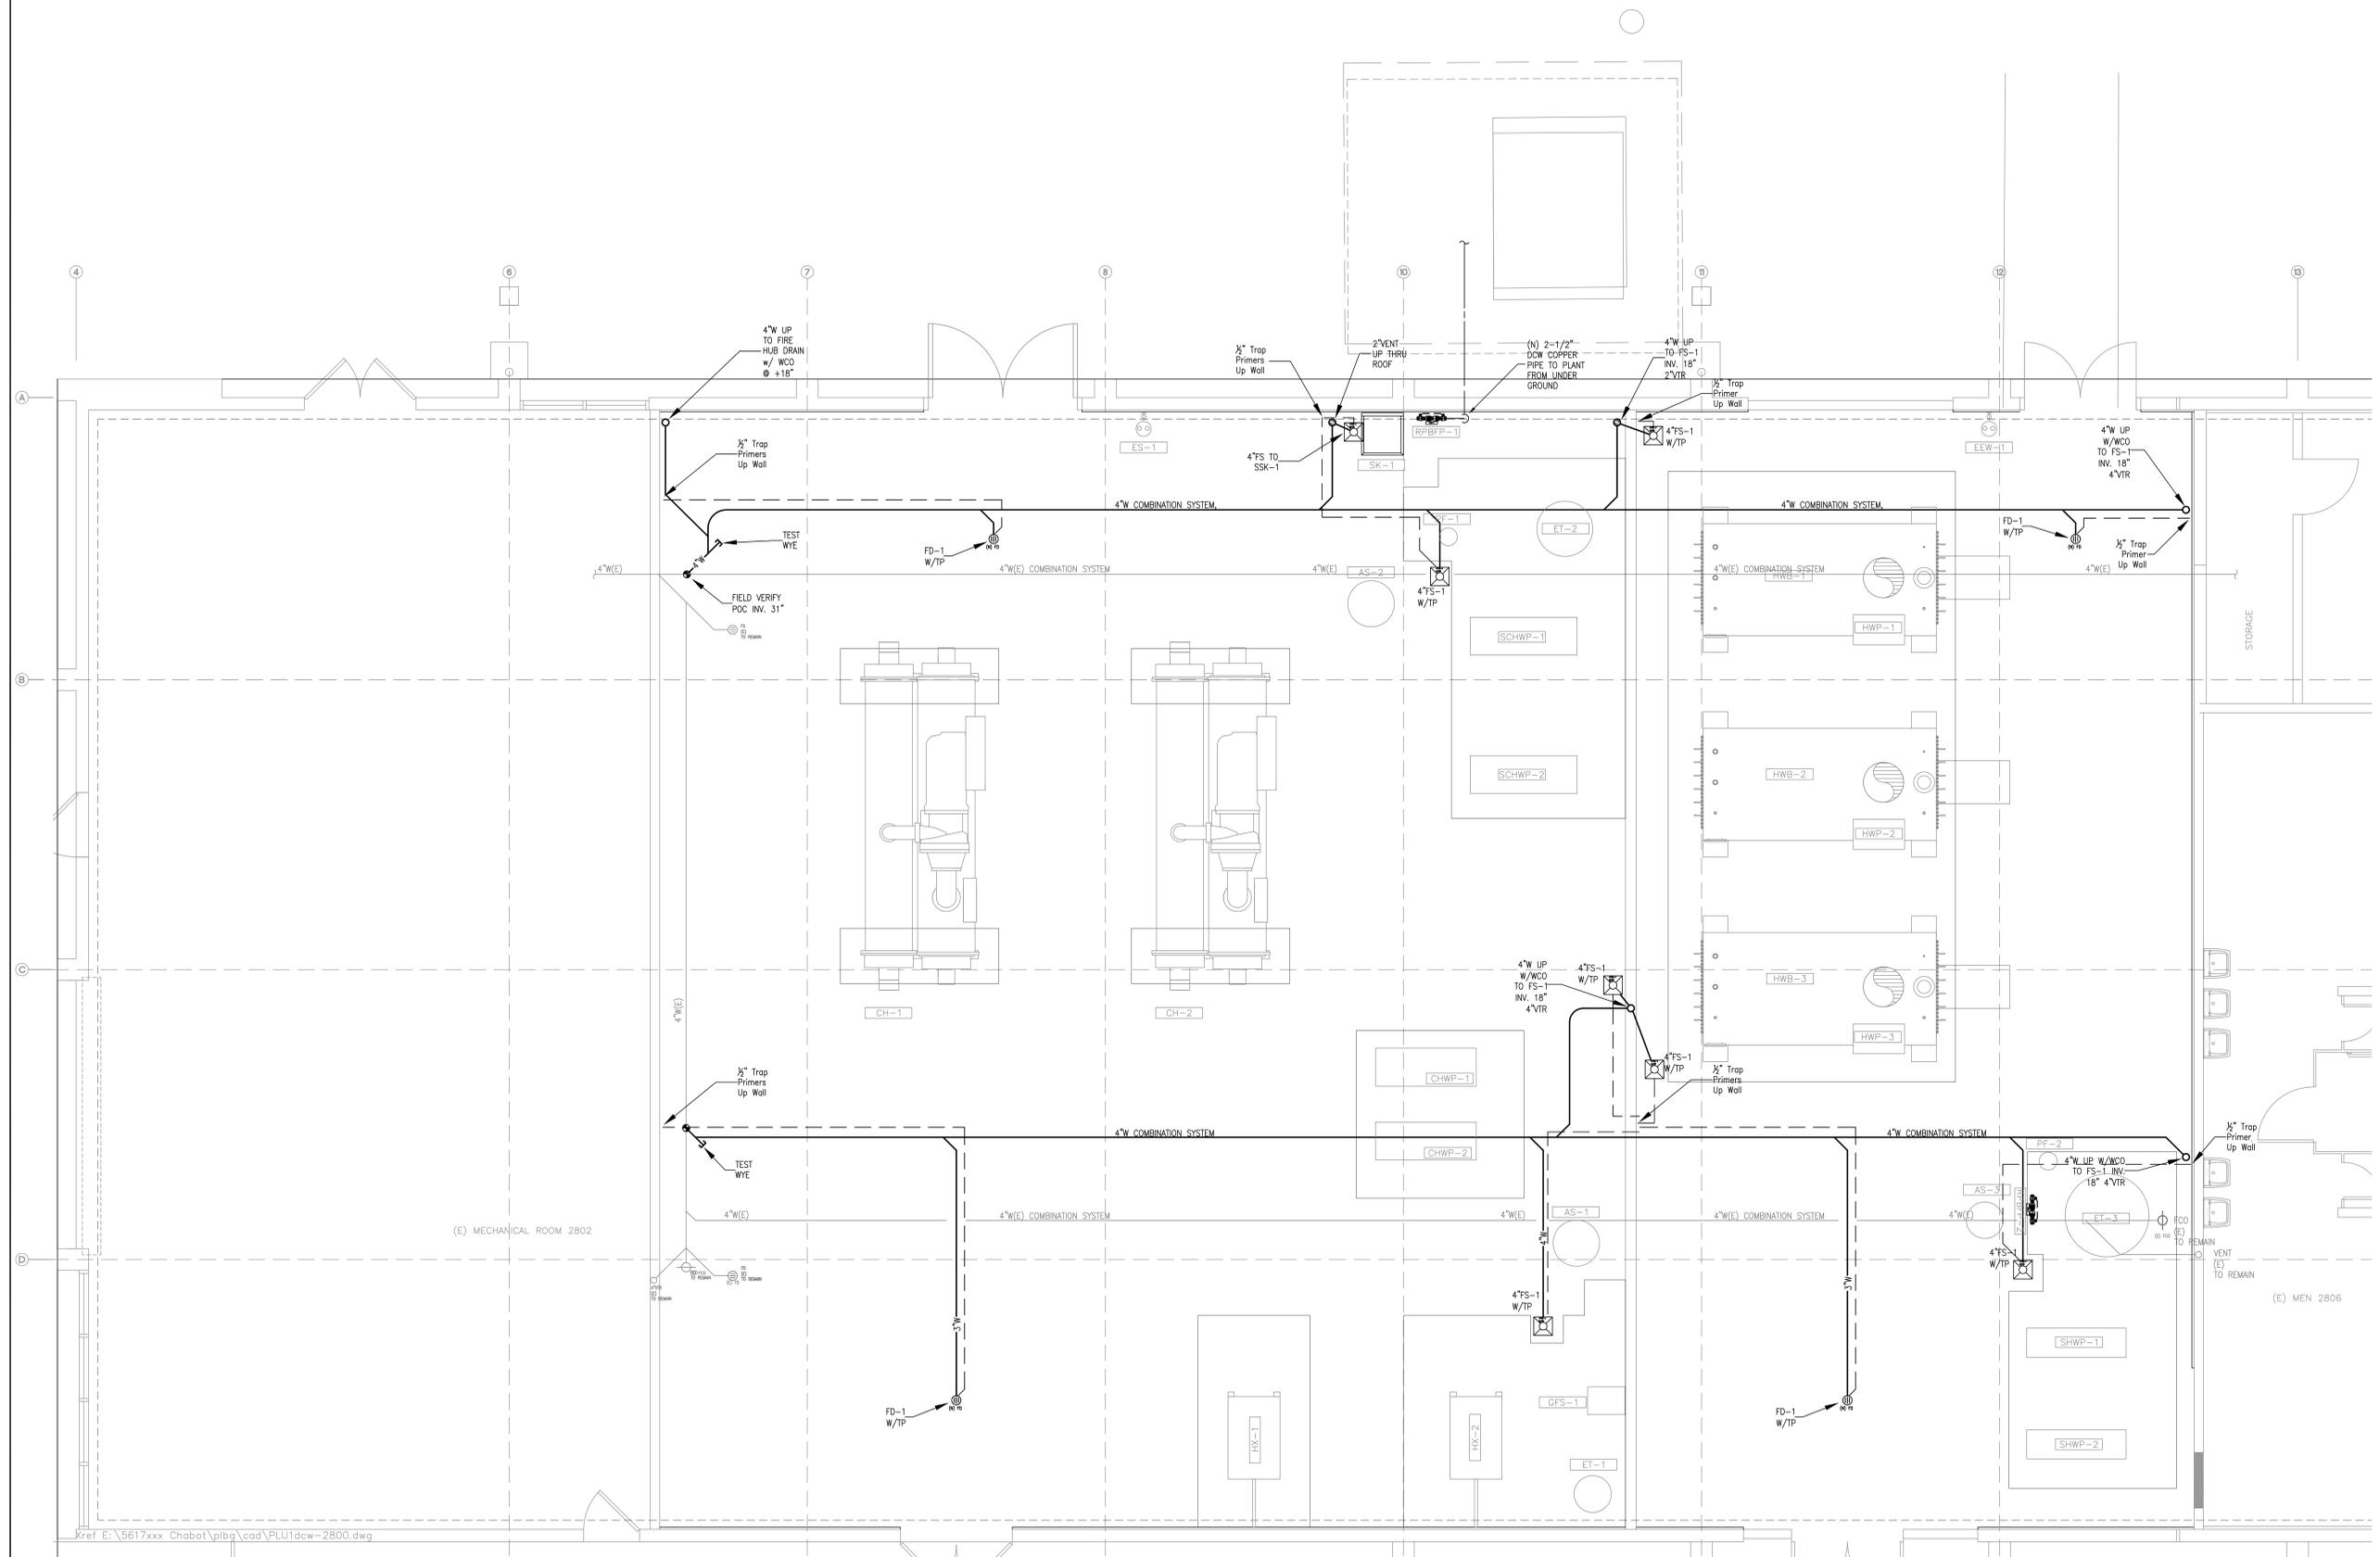

Kref E:\5617xxx Chabot\plbg\cad\PLU1dcw-2800.dwg



25555 HESPERIAN BLVD,
HAYWARD, CALIFORNIA


THE INCORPORATED STATE OF CALIFORNIA REGISTERED PROFESSIONAL ENGINEERS STAMP SERVES AS THE SELF CERTIFICATION FOR THESE DOCUMENTS.

SOUTHLAND INDUSTRIES

 775 Commercial Street
 San Jose, CA 95112
 Tel: 408.970.3777
 Fax: 408.970.3776

ALL DRAWINGS PREPARED BY SOUTHLAND INDUSTRIES ARE THE EXCLUSIVE PROPERTY OF SOUTHLAND INDUSTRIES AND, UNLESS OTHERWISE AGREED IN WRITING, SOUTHLAND INDUSTRIES SHALL BE DEEMED THE AUTHOR OF THEM AND SHALL RETAIN ALL COMMON LAW, STATUTORY AND OTHER RESERVED RIGHTS. IN ADDITION TO THE COPYRIGHT, ANY USE THEREOF WITHOUT THE EXPRESS WRITTEN CONSENT OF SOUTHLAND INDUSTRIES IS PROHIBITED


NO.	DESCRIPTION	DATE
0	DSA PERMIT SET	02/21/08
1	DSA BACK CHECK	06/26/08
2	FIRE DEPT PERMIT SET	09/03/08
3	AS-BUILT	02/18/09

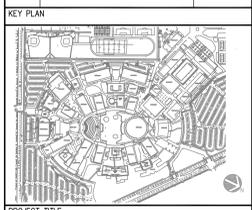

PROJECT TITLE
**CHABOT COMMUNITY COLLEGE
 CENTRAL PLANT**
 25555 HESPERIAN BLVD,
 HAYWARD, CALIFORNIA

SHEET TITLE
 ENLARGED PARTIAL PLUMBING UNDERGROUND YARD PLAN

DRAWN BY C. Garcia	CHECKED BY
PROJECT NO. 5617065	SHEET NO. PL.42
SCALE: 1/2" = 1'-0"	
DATE 06-26-2008	

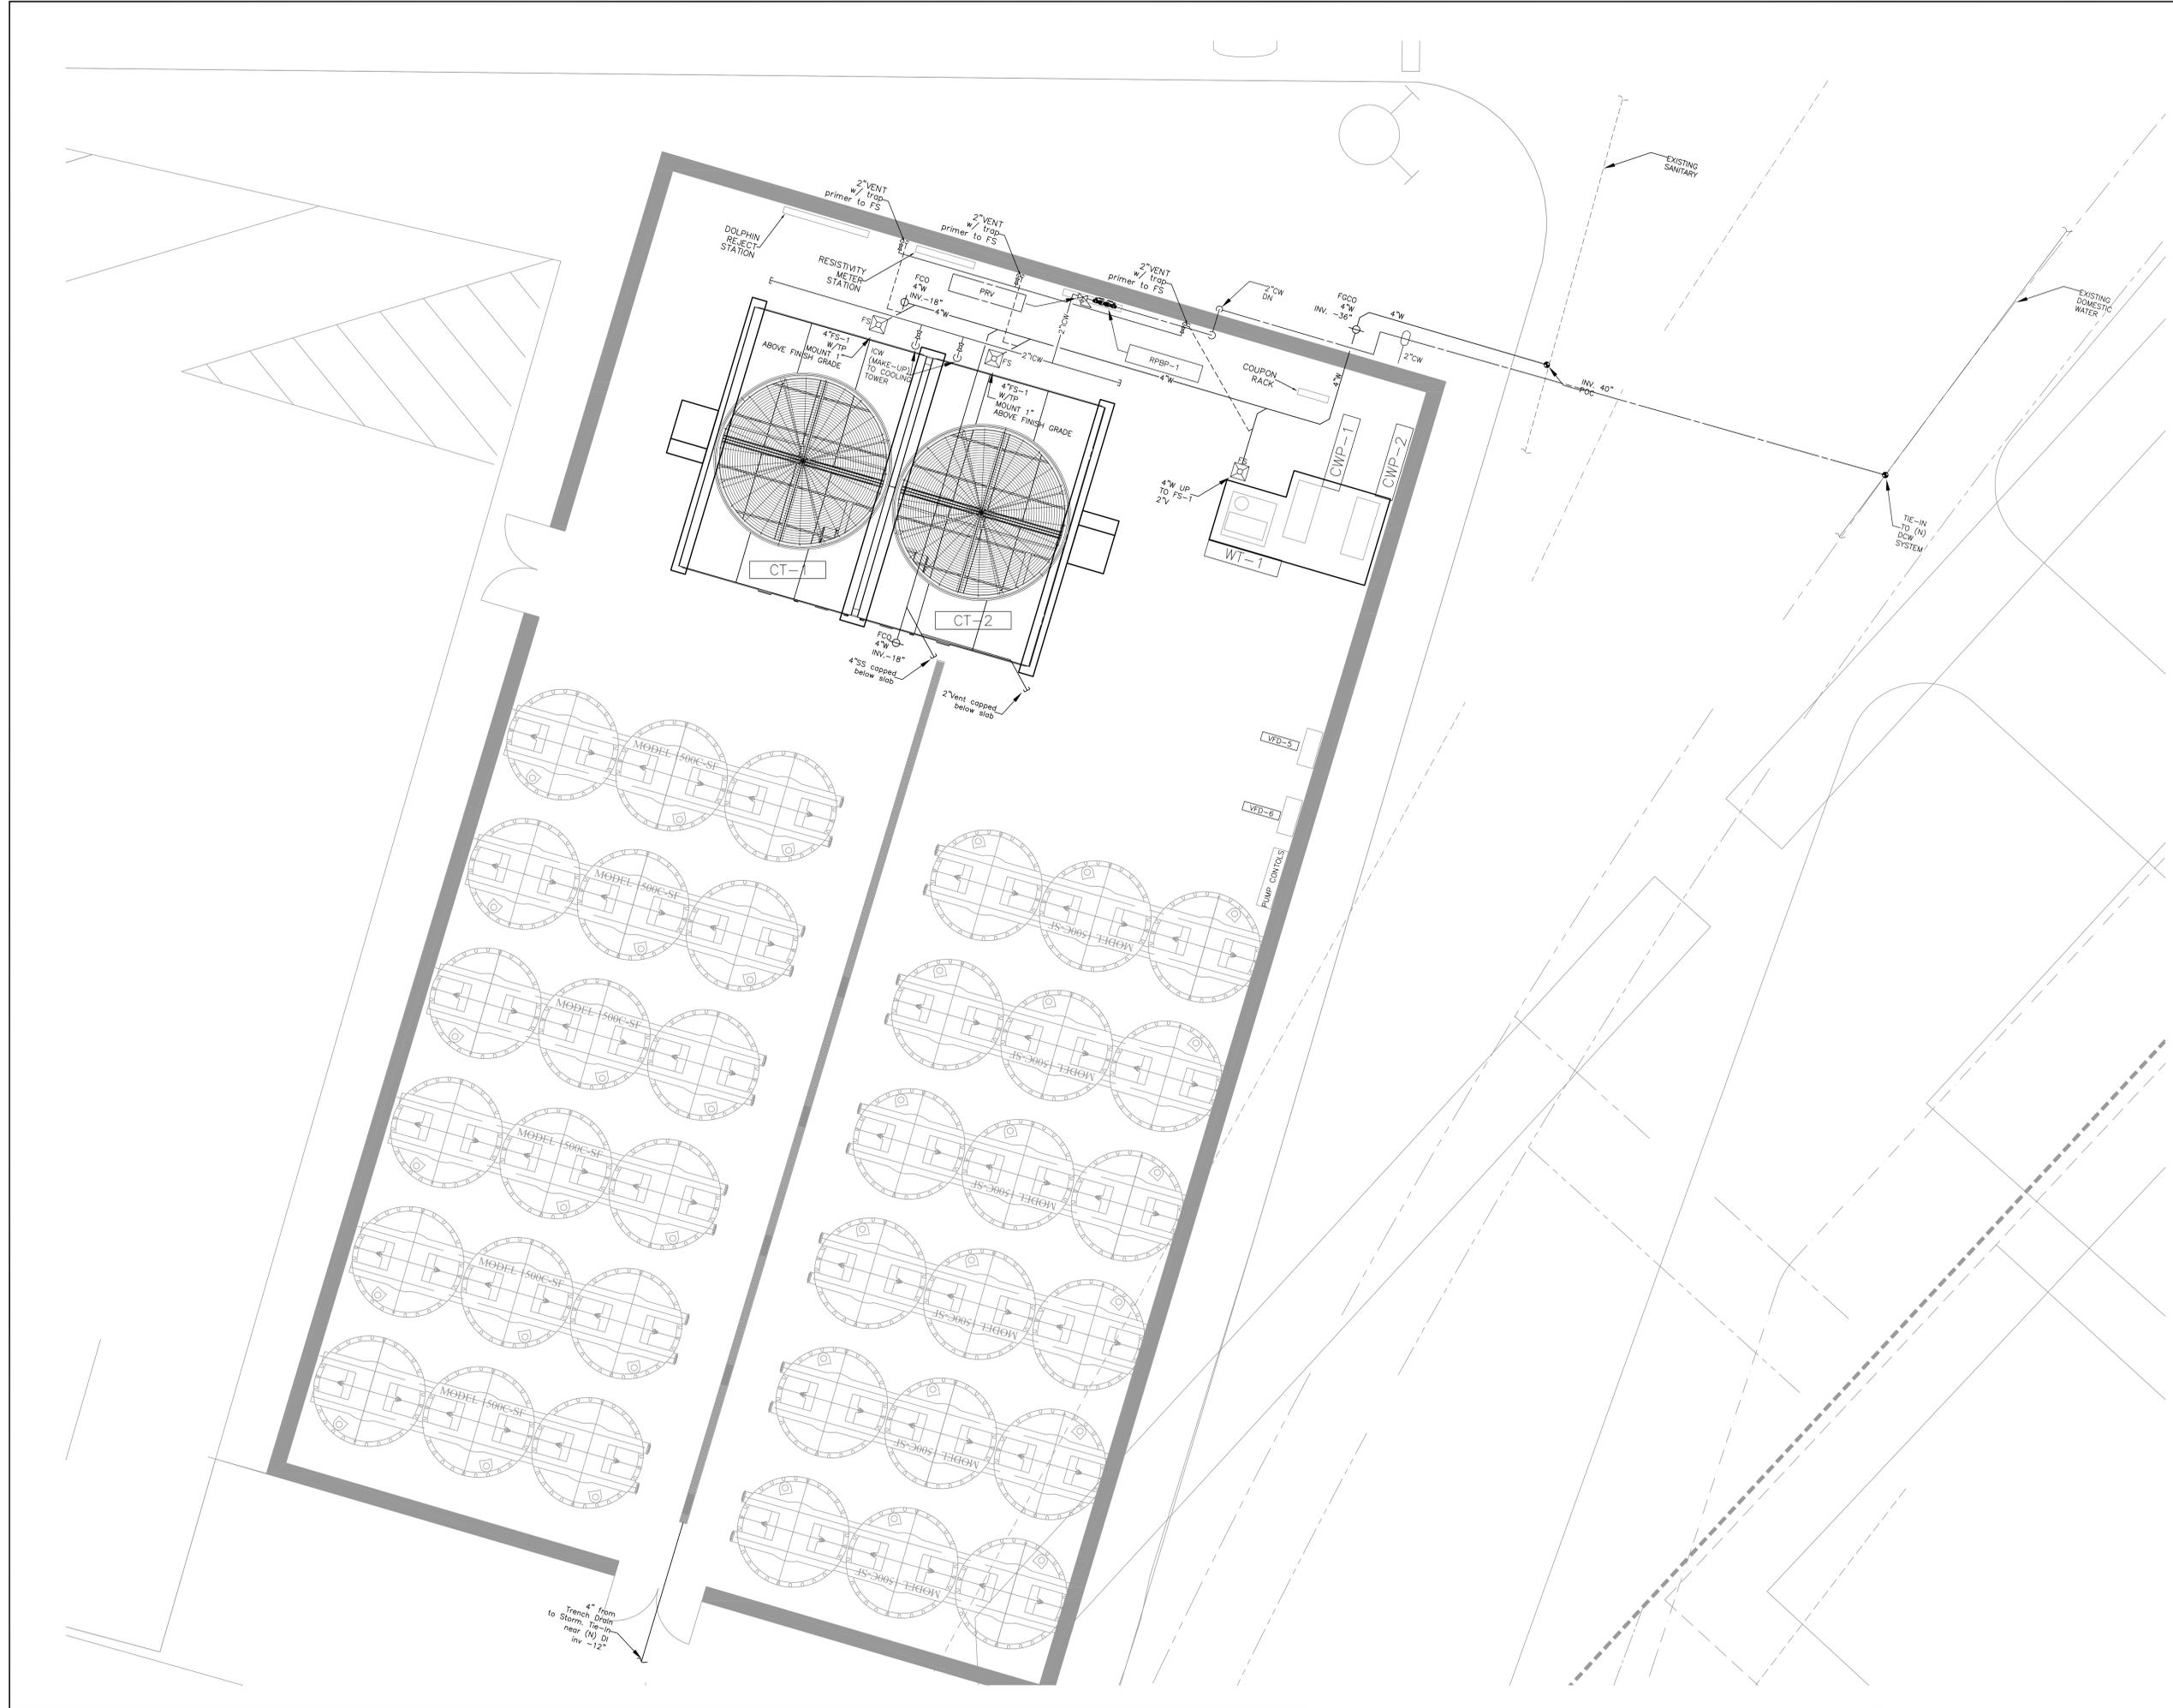




25555 HESPERIAN BLVD,
HAYWARD, CALIFORNIA

THE INCORPORATED STATE OF CALIFORNIA REGISTERED PROFESSIONAL ENGINEERS STAMP SERVES AS THE SELF CERTIFICATION FOR THESE DOCUMENTS.

SOUTHLAND INDUSTRIES
 775 Commercial Street
 San Jose, CA 95112
 Tel: 408.970.3777
 Fax: 408.970.3776

ALL DRAWINGS PREPARED BY SOUTHLAND INDUSTRIES ARE THE EXCLUSIVE PROPERTY OF SOUTHLAND INDUSTRIES AND, UNLESS OTHERWISE AGREED IN WRITING, SOUTHLAND INDUSTRIES SHALL BE DEEMED THE AUTHOR OF THEM AND SHALL RETAIN ALL COMMON LAW, STATUTORY AND OTHER RESERVED RIGHTS, IN ADDITION TO THE COPYRIGHT. ANY USE THEREOF WITHOUT THE EXPRESS WRITTEN CONSENT OF SOUTHLAND INDUSTRIES IS PROHIBITED


NO.	DESCRIPTION	DATE
0	DSA PERMIT SET	02/21/08
1	DSA BACK CHECK	06/26/08
2	FIRE DEPT PERMIT SET	09/03/08
3	AS-BUILT	02/18/09

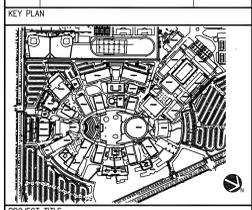

PROJECT TITLE
**CHABOT COMMUNITY COLLEGE
 CENTRAL PLANT**
 25555 HESPERIAN BLVD,
 HAYWARD, CALIFORNIA

SHEET TITLE
 BUILDING 2800
 ENLARGED PARTIAL
 PLUMBING FLOOR PLAN

DRAWN BY C. Garcia	CHECKED BY
PROJECT NO. 5617065	UNIT
SCALE:	SHEET NO. PL43
DATE 06-26-2008	

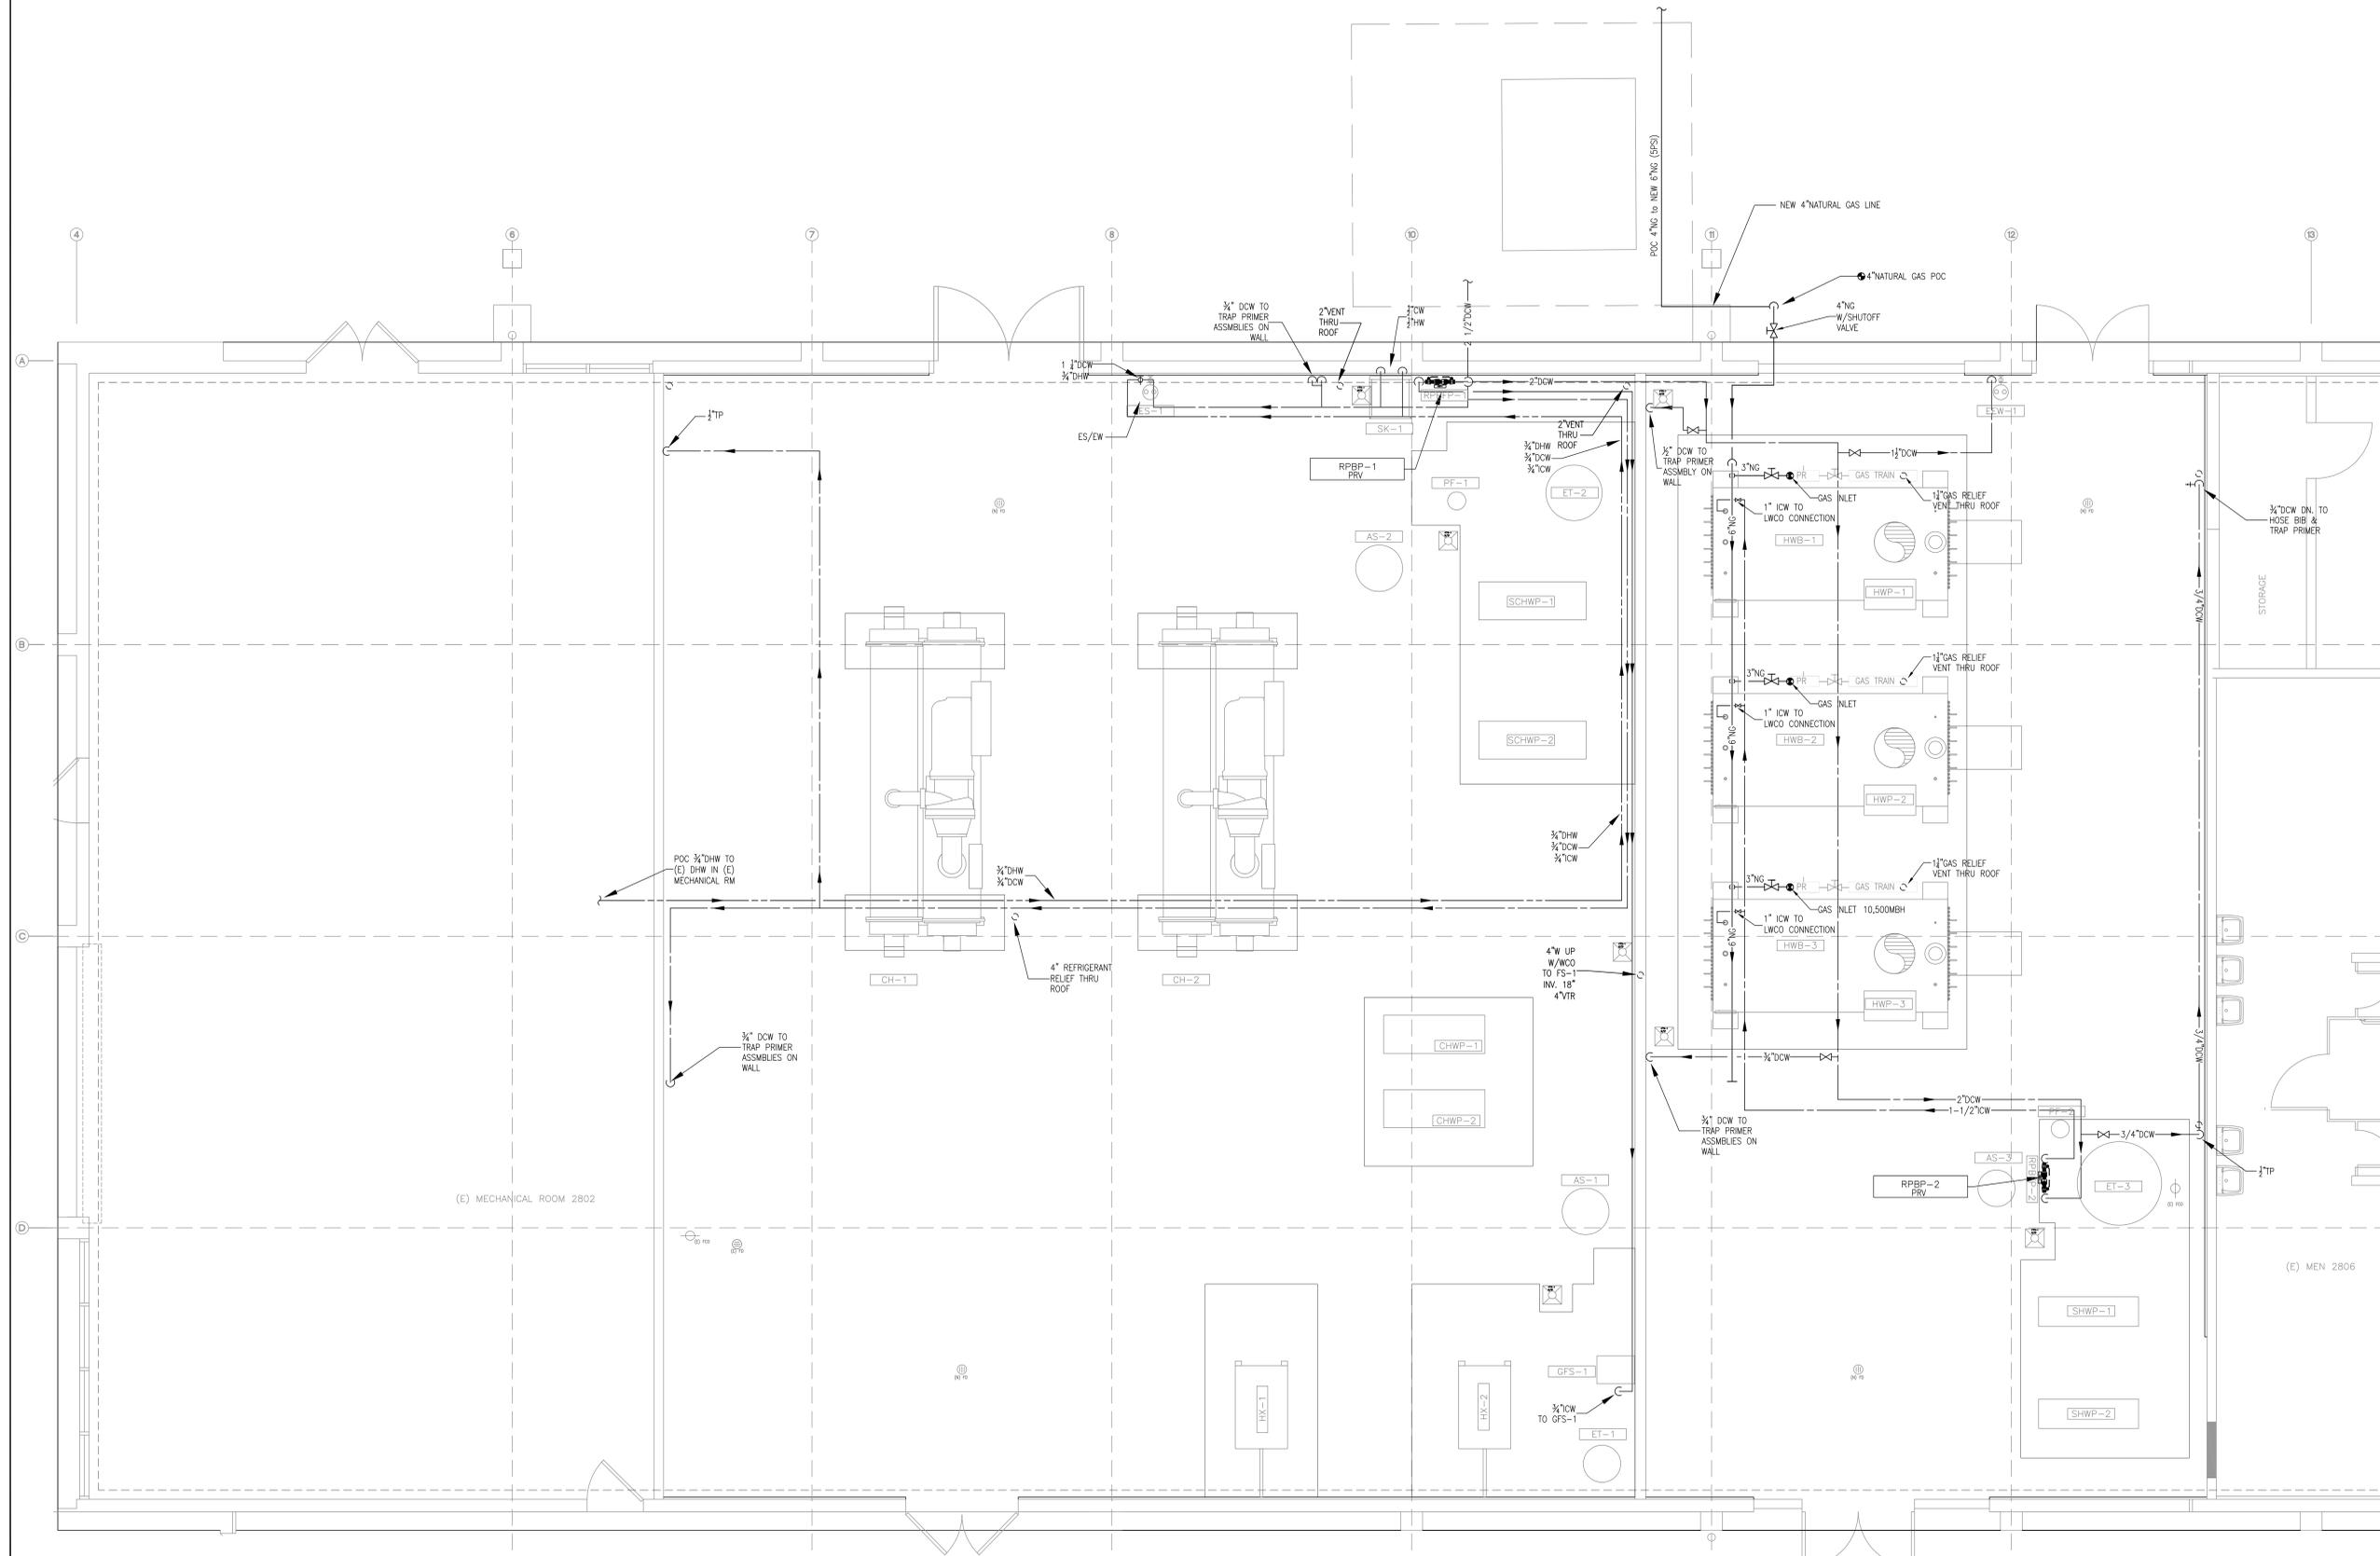



25555 HESPERIAN BLVD,
HAYWARD, CALIFORNIA


THE INCORPORATED STATE OF CALIFORNIA REGISTERED PROFESSIONAL ENGINEERS STAMP SERVES AS THE SELF CERTIFICATION FOR THESE DOCUMENTS.

SOUTHLAND INDUSTRIES

 775 Commercial Street
 San Jose, CA 95112
 Tel: 408.970.3777
 Fax: 408.970.3776

ALL DRAWINGS PREPARED BY SOUTHLAND INDUSTRIES ARE THE EXCLUSIVE PROPERTY OF SOUTHLAND INDUSTRIES AND, UNLESS OTHERWISE AGREED IN WRITING, SOUTHLAND INDUSTRIES SHALL BE DEEMED THE AUTHOR OF THEM AND SHALL RETAIN ALL COMMON LAW, STATUTORY AND OTHER RESERVED RIGHTS, IN ADDITION TO THE COPYRIGHT, ANY USE THEREOF WITHOUT THE EXPRESS WRITTEN CONSENT OF SOUTHLAND INDUSTRIES IS PROHIBITED

NO.	DESCRIPTION	DATE
0	DSA PERMIT SET	02/21/08
1	DSA BACK CHECK	06/26/08
2	FIRE DEPT PERMIT SET	09/03/08
3	AS-BUILT	02/18/09

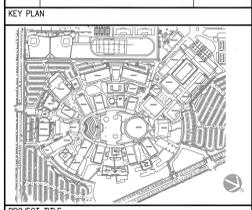

PROJECT TITLE
**CHABOT COMMUNITY COLLEGE
 CENTRAL PLANT**
 25555 HESPERIAN BLVD,
 HAYWARD, CALIFORNIA

SHEET TITLE
 BUILDING 2800
 ENLARGED PARTIAL
 PLUMBING - ROOF PLAN

DRAWN BY C_Garcia	CHECKED BY
PROJECT NO. 5617065	SHEET NO. PL4.4
SCALE:	
DATE 06-26-2008	

